

Monroe
L 2003
11-25-75

MISSISSIPPI
BOARD OF WATER COMMISSIONERS
416 North State Street
Jackson, Mississippi 39201

WATER WELL DRILLERS LOG

Herman Homan Well & Supply, Inc.


P. O. Box 42

SHANNON, MISSISSIPPI 38866

11/25 1975
date well completed

Monroe
county well located

LANDOWNER:	description of formations encountered	from	to
Earl Morris Abbeedon, Miss (mailing address)	Surface sand Blue clay Sand Gravel	0 38 60 150	38 60 180
WELL LOCATION: sec. 21 T. 14 N. R. 7 E S W 1/4 miles North of Abbeedon (distance) (direction) (nearest town)			
WELL PURPOSE: <u>farm</u> (home, irrigation, municipal, industrial)			
WELL COMPLETION DATA:			
(1) diameter (inches) <u>4"</u>			
(2) total depth (feet) <u>180'</u>			
(3) static water level (feet) <u>37'</u> below above top of ground.			
(4) casing <u>steel</u> , <u>42'</u> (material) (depth) <u>4"</u> (size) if telescope see back.			
(5) screen <u>no</u> (length) (depth to top) (size) (material)			
(6) pump <u>1/2</u> <u>5</u> (HP) (yield gpm) <u>elec</u> (type power)			
(7) electric log <u>no</u> (yes or no)			
(organization running log)			
(8) how well bottom plugged <u>open</u>			
DRILLERS REMARKS:			

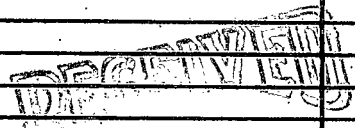


DEC 15 1975

WATER COMMISSIONERS

If well telescopes please sketch and show depths.

GROUND LEVEL

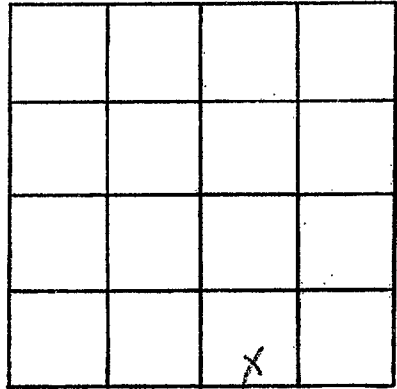

SECTION 21

Please indicate well location X.

ADDITIONAL INFORMATION

If more than one screen,
show locations of each on sketch.