

MONROE
L 2005
9-27-77

MISSISSIPPI
BOARD OF WATER COMMISSIONERS
416 North State Street
Jackson, Mississippi 39201

WATER WELL DRILLERS LOG

9/27/77
date well completed

19 Getivens Drilling Service
firm name

Monroe Co. MS
county well located

LANDOWNER: Louisiana Land & Exploration Co.
P.O. Box 60350 New Orleans La.
(mailing address)

WELL LOCATION:
sec. 30 T. 14 N. R. 7 E.
3 miles S of Aberdeen
(distance) (direction) (nearest town)

WELL PURPOSE:
(home, irrigation, municipal, industrial)

- WELL COMPLETION DATA:
- (1) diameter (inches) 3"
 - (2) total depth (feet) 525
 - (3) static water level (feet) 80' below above top of ground.
 - (4) casing Steel, 504,
(material) (depth)
(size) If telescope see back.
 - (5) screen
(length) (depth to top)
(size) (material)
 - (6) pump 55
(HP) (yield gpm)
AC
(type power)
 - (7) electric log NO
(yes or no)
(organization running log)
 - (8) how well bottom plugged

DRILLERS REMARKS:

| description of formations encountered | from to | |
|---------------------------------------|---------|-----|
| | | |
| Clay (Hard) | 0 | 189 |
| Clay | 189 | 231 |
| Sand | 231 | 250 |
| Clay | 250 | 480 |
| Sand | 480 | 500 |


RECEIVED

SEP 29 1977

MISS. BD. OF WATER COMMISSIONERS

If well telescopes please sketch and show depths.

GROUND LEVEL

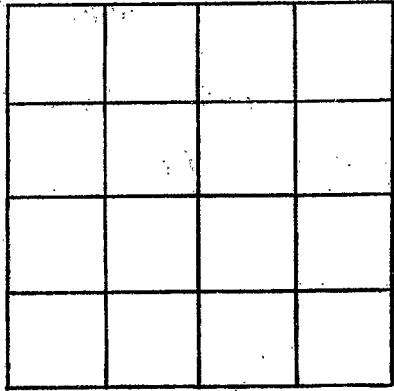

SECTION _____

Please indicate well location X.

ADDITIONAL INFORMATION

If more than one screen, show locations of each on sketch.