

MONROE
L 2006
3/1/78

MISSISSIPPI
BOARD OF WATER COMMISSIONERS
416 North State Street
Jackson, Mississippi 39201

WATER WELL DRILLERS LOG

3-1-78 date well completed
Herman Homan Well & Supply, Inc.
P.O. Box 42
firm name
SHANNON, MISSISSIPPI 38868
Monroe county well located

LANDOWNER:
John HAWA
Aberdeen, Ms.
(mailing address)

WELL LOCATION:
sec. 29 T. 14 N. R. 6 E S
1 miles W of Abade.
(distance) (direction) (nearest town)

WELL PURPOSE: Shop
(home, irrigation, municipal, industrial)

- WELL COMPLETION DATA:
- (1) diameter (inches) 4"
 - (2) total depth (feet) 240'
 - (3) static water level (feet) 69' below above top of ground.
 - (4) casing (material) Steel, (depth) 106'
 - 4" (size) if telescope see back.
 - (5) screen (length) 10' (depth to top)
 - (size) (material)
 - (6) pump 3/4 (HP) 7 (yield gpm)
 - electr (type power)
 - (7) electric log (yes or no) NO
 - (organization running log)
 - (8) how well bottom plugged open

| description of formations encountered | from | to |
|---------------------------------------|------|-----|
| Surface sand | | |
| clay | 0 | 39 |
| blue clay | 39 | 120 |
| sand | 120 | 240 |
| stone | 240 | |

DRILLERS REMARKS:


RECEIVED

MAR 23 1978

WATER COMM

If well telescopes please sketch and show depths.

GROUND LEVEL

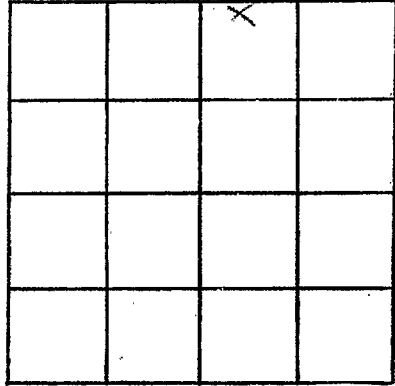

SECTION 29

Please indicate well location X.

ADDITIONAL INFORMATION

If more than one screen, show locations of each on sketch.