

MISSISSIPPI DEPARTMENT OF NATURAL RESOURCES

Bureau of Land and Water Resources

Southport Mall

P.O. Box 10631

Jackson, Mississippi 39209

WATER WELL DRILLERS LOG

TOM GRIFFITH

PLUMBING & WELL SERVICE, INC.

320 MAYSON AVE.

Monroe county well located

Monroe
L 2007

9-4-83 19
date well completed

LANDOWNER: Pruet Production

1515 Capital Avenue

Jackson, MS 39201
(mailing address)

WELL LOCATION:

sec. 32 T 14 N R 7 (E)

2 miles (distance) W (direction) of Aberdeen (nearest town)

WELL PURPOSE: Oil Location
(home, irrigation, municipal, industrial)

WELL COMPLETION DATA:

- (1) diameter (inches) 4"
- (2) total depth (feet) 250'
- (3) static water level (feet) 75' below above top of ground.
- (4) casing PUC, 200',
(material) (depth)
- N/A (size) if telescope see back.
- (5) screen 50', 200'
(length) (depth to top)
- 4", PUC
(size) (material)
- (6) pump 3 5
(HP) (yield gpm)
- electric
(type power)
- (7) electric log NO
(yes or no)
- N/A
(organization running log)
- (8) how well bottom plugged BWU


description of fomations encountered	from	to
Chalk	0'	18'
sand	18'	45'
Limestone	45'	130'
sand	130'	150'
Limestone	150'	160'
Sand	160'	165'
Streaked Sand & Limestone	165'	190'
Rock	190'	191'
Streaked Sand &	191'	200'
Sand	200'	250'

DRILLERS REMARKS: Very Tight Sand - Need 150 GPM but only 5 GPM

DEPT. OF NATURAL RESOURCES
BUREAU OF LAND & WATER RESOURCES
DEG 15 1983
RECEIVED

If well telescopes please sketch and show depths.

GROUND LEVEL

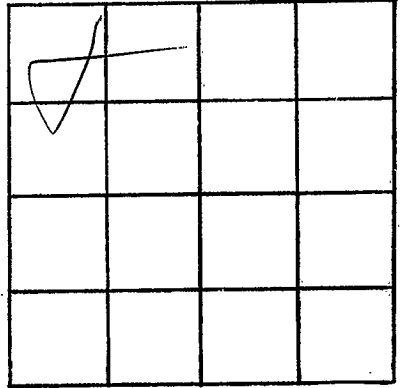

SECTION 32

Please indicate well location X.

ADDITIONAL INFORMATION

If more than one screen,
show locations of each on sketch.