

**MISSISSIPPI DEPARTMENT OF ENVIRONMENTAL QUALITY**  
Office of Land and Water Resources

P. O. Box 10631  
Jackson, MS 39289-0631  
**WATER WELL DRILLERS LOG**

COUNTY WELL LOCATED <i>Montone</i>	
WELL NUMBER <i>L-2013</i>	CODED
DATE WELL COMPLETED <i>8-26-00</i>	

PERMIT NUMBER <i>0-509</i>
NAME OF DRILLING FIRM <i>Rosse Drilling</i>

NAME & MAILING ADDRESS OF LANDOWNER <i>Dennis Jackson</i>			
<i>50014 Richardson Rd</i>			
<i>Amory MS 38821</i>			
WELL LOCATION	SEC	TOWNSHIP	RANGE
	<i>30</i>	<i>14</i>	<i>N 19 E</i>
DISTANCE	DIRECTION	NEAREST TOWN	
OTHER LANDMARK			
WELL PURPOSE: Home, Irrigation, Municipal, Industrial, Fish Pond, etc. <i>Home</i>			

<b>PUMP DATA</b>		
PUMP TYPE (Circle One): <input checked="" type="radio"/> <i>Submersible</i> Turbine, Jet, Flowing Well, Other (Describe) _____		
POWER TYPE (Circle One): <input checked="" type="radio"/> <i>Electric</i> Tractor, Diesel, Gasoline, Butane, Other (Describe) _____ H/P <i>1</i>		
Pump Capacity (GPM)	No. of Stages	Setting Depth  FT.
<b>PUMP TEST</b>		
Well yielded _____ GPM with a drawdown of _____ ft. after _____ hours of pumping		

<b>WELL DATA</b>		
Well Depth <i>45</i>	Casing Diameter (In.) <i>4"</i>	Casing Length (Ft.) <i>35'</i>
Type of Casing <i>PVC</i>	Hole Depth	Depth to Static Water Level <i>22</i>
TYPE OF COMPLETION: (Circle One or More): <input checked="" type="checkbox"/> <i>Gravel Packed</i> , Underreamed, Telescoped, Natural Development, Open Hole, Other		

<b>LOG DATA</b>	
TYPE OF LOG RUN (Circle One): No Log Run, Electric, Gamma Ray, Density, Sonic, Neutron, Other (Describe) <i>none</i>	
Name of Organization Running Log <i>none</i>	

WELL GROUTED TO A DEPTH OF _____ FEET Type Grout (circle one): Cement, Bentonite, or Mix
---

<b>GEOLOGIC DATA (Office Use Only)</b>			
Surface Elev.	Geologic Unit	Unit Thickness	Depth to Top
Subs. SWL	Date	Analysis	Aquifer Test

<b>SCREEN DATA</b>		
Diameter - Inches <i>4"</i>	Length - Feet <i>10'</i>	Slot Size - Inches <i>0.010</i>
Screen Type <i>PVC</i>	Depth to Bottom - Feet <i>10'</i>	


Driller's Remarks
Top of Lap Pipe or Reduction in Casing  FEET <input type="checkbox"/> IF TELESCOPED OR MORE THAN ONE SCREEN: USE BACK PAGE

DESCRIPTION OF FORMATIONS ENCOUNTERED	FORMATIONS (Continued)	
	FROM	TO
<i>clay</i>	<i>0</i>	<i>18</i>
<i>sand + gravel</i>	<i>18</i>	<i>45</i>

**REC'D JUN 25 2001**

If well telescopes please  
sketch and show depths.

GROUND LEVEL

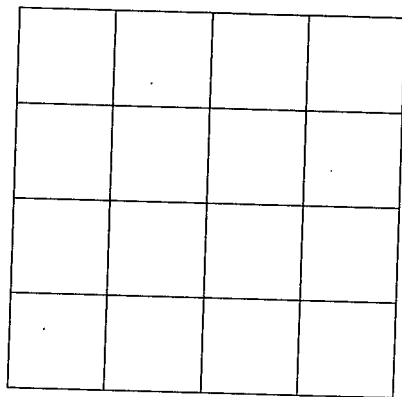

SECTION \_\_\_\_\_

Please indicate well location X.

ADDITIONAL INFORMATION

If more than one screen,  
show location of each on sketch.