

Monroe
~~Q~~
 M

MISSISSIPPI DEPARTMENT OF NATURAL RESOURCES
 Bureau of Land and Water Resources
 Southport Mall
 P.O. Box 10631
 Jackson, Mississippi 39209
 WATER WELL DRILLERS LOG

Oct 13-82 19 Parks & Parks Well Service Monroe
 date well completed firm name county well located

LANDOWNER:	description of formations encountered	from	to
RONALD Forrester RT 2 BOX A 259 Hamilton MISS (mailing address)			
WELL LOCATION:	Red Sand	17	50
sec 36 T 14 N R 18 E 7 miles NE of Hamilton (distance) (direction) (nearest town)	Clay	50	60
WELL PURPOSE: Home (home irrigation, municipal, industrial)	Fines Red Sand	60	100
WELL COMPLETION DATA:	Clay & Fine Sand	100	130
(1) diameter (inches) 4"	Rock + Gray Sand	130	190
(2) total depth (feet) 190			
(3) static water level (feet) 120 below top of ground.			
(4) casing PVC 178' (material) (depth)			
(size) If telescope see back.			
(5) screen 10' 178' (length) (depth to top)			
4" PVC (size) (material)			
(6) pump 1/2 6 (HP) (yield gpm)			
(type power)			
(7) electric log No (yes or no)			
(organization running log)			
(8) how well bottom plugged 4" op			

DEPT. OF NATURAL RESOURCES
 BUREAU OF LAND & WATER RESOURCES


OCT 29 1982

RECEIVED

DRILLERS REMARKS:

If well telescopes please sketch and show depths.

GROUND LEVEL

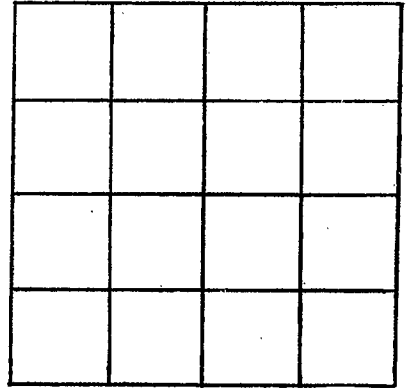

SECTION _____

Please indicate well location X.

ADDITIONAL INFORMATION

If more than one screen,
show locations of each on sketch.