

MONROE
M 15
8-12-70

MISSISSIPPI
BOARD OF WATER COMMISSIONERS
416 North State Street
Jackson, Mississippi 39201

CODED

WATER WELL DRILLERS LOG

8-12 1970 W. J. REEVES & SON MONROE
date well completed firm name county well located

LANDOWNER: W. C. LAW
Arhens - 369 4490
RT. 2

description of formations encountered	from	to
	CLAY	0
SAND & GRAVEL	17	47

ABERDEEN
(mailing address)

WELL LOCATION:
sec. 7 T 14 S R 18 W
5 miles NE of ABERDEEN
(distance) (direction) (nearest town)

WELL PURPOSE: HOME
(home, irrigation, municipal, industrial)

CODED

- WELL COMPLETION DATA:
- (1) diameter (inches) 4
 - (2) total depth (feet) 47
 - (3) static water level (feet) 20 below top of ground.
 - (4) casing PVC 27 (material) (depth)
4 (size) if telescope see back.
 - (5) screen 20 27 (length) (depth to top)
4 PVC (size) (material)
 - (6) pump 1 20 (HP) (yield gpm)
ELECT (type power)
 - (7) electric log No (yes or no)
 - (8) how well bottom plugged SAND


DRILLERS REMARKS:

MISS. BD. OF
WATER COMM.

AUG 25 1970

If well telescopes please sketch and show depths.

GROUND LEVEL

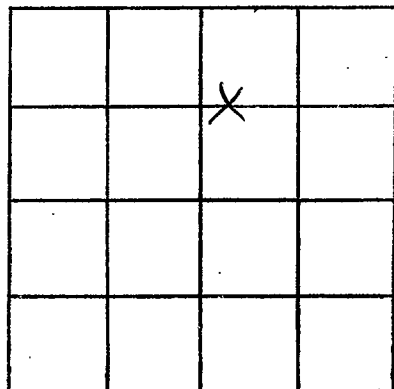

SECTION 7

Please indicate well location X.

ADDITIONAL INFORMATION

If more than one screen, show locations of each on sketch.