

MONROE
M16
8-13-70

MISSISSIPPI
BOARD OF WATER COMMISSIONERS
416 North State Street
Jackson, Mississippi 39201

CODED

WATER WELL DRILLERS LOG

8-13 1970 W.J. REEVES & SON MONROE
date well completed firm name county well located

LANDOWNER: J. T. DEATON

HAMILTON

(mailing address)

WELL LOCATION:

sec. 33 T 14 S R 18 W
6 miles E of ABERNETHY
(distance) (direction) (nearest town)

WELL PURPOSE: HOME
(home, irrigation, municipal, industrial)

WELL COMPLETION DATA:

- (1) diameter (inches) 4
- (2) total depth (feet) 85 1/2
- (3) static water level (feet) 49 below/above top of ground.
- (4) casing PVC, 65 1/2
(material) (depth)
4 if telescope see back.
(size)
- (5) screen 20', 65 1/2
(length) (depth to top)
4", PVC
(size) (material)
- (6) pump 1/2, 10
(HP) (yield gpm)
EJECT.
(type power)
- (7) electric log NO
(yes or no)

(organization running log)
- (8) how well bottom plugged SAND

description of formations encountered

from

to

RED CLAY 0 22
RED SAND 22 84
BLUE CLAY 84 85 1/2

CODED


NOV 25 1970

DRILLERS REMARKS:

MISS. DIV. OF
WATER CONTROL

If well telescopes please sketch and show depths.

GROUND LEVEL

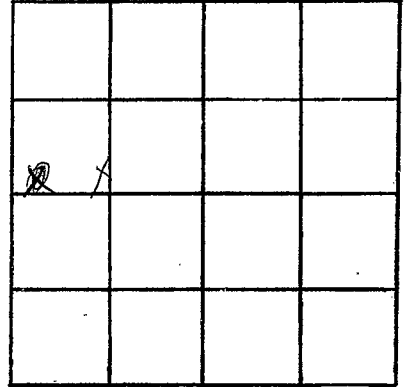

SECTION 33

Please indicate well location X.

ADDITIONAL INFORMATION

If more than one screen,
show locations of each on sketch.