

MONROE
M 20
10-2-72

MISSISSIPPI
BOARD OF WATER COMMISSIONERS
416 North State Street
Jackson, Mississippi 39201

CODED

WATER WELL DRILLERS LOG

10-2 1972 W. J. REEVES, JR. MONROE
date well completed firm name county well located

LANDOWNER: CECIL TUBB

description of formations encountered

from

to

RT. 2

ABERDEEN

(mailing address)

CLAY 0 17
SAND & GRAVEL 17 42 1/2

WELL LOCATION:

sec. 6 T. 14 R. 18
6 miles NE of ABERDEEN
(distance) (direction) (nearest town)

WELL PURPOSE: HOME
(home, irrigation, municipal, industrial)

WELL COMPLETION DATA:

- (1) diameter (inches) 4
- (2) total depth (feet) 42 1/2
- (3) static water level (feet) 15 below above top of ground.
- (4) casing PVC, 22 1/2 (material), (depth)
4 (size) if telescope see back.
- (5) screen 20, 22 1/2 (length), (depth to top)
4 (size), PVC (material)
- (6) pump 1/2, 10 (HP), (yield gpm)
ELECT (type power)
- (7) electric log NO (yes or no)
- (organization running log)
- (8) how well bottom plugged WOOD


CODED

FEB 12 1972

DRILLERS REMARKS:

If well telescopes please sketch and show depths.

GROUND LEVEL

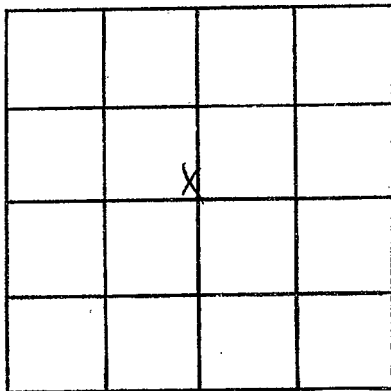

SECTION 6

Please indicate well location X.

ADDITIONAL INFORMATION

If more than one screen, show locations of each on sketch.