

MONROE
M 22
11-11-72

MISSISSIPPI
BOARD OF WATER COMMISSIONERS
416 North State Street
Jackson, Mississippi 39201

CODED

WATER WELL DRILLERS LOG

11-11-72 date well completed 1972 W. J. REEVES, SR. firm name MONROE county well located

LANDOWNER: CARY FRITCH
P.O. 2
ABERDEEN
(mailing address)

description of formations encountered	from	to
<u>RD. CLAY</u>	<u>0</u>	<u>22</u>
<u>RD. SAND</u>	<u>22</u>	<u>118</u>
<u>BLUE CLAY</u>	<u>118</u>	<u>120</u>

WELL LOCATION:
sec 26 T. 14 S. R. 18 E.
9 miles E of ABERDEEN
(distance) (direction) (nearest town)

WELL PURPOSE: HOME
(home, irrigation, municipal, industrial)

- WELL COMPLETION DATA:
- (1) diameter (inches) 4
 - (2) total depth (feet) 120
 - (3) static water level (feet) 60 below above top of ground.
 - (4) casing PVC, 100,
(material) (depth)
4 if telescope see back.
(size)
 - (5) screen 20, 100
(length) (depth to top)
4 (size) PVC (material)
 - (6) pump 1/2, 10
(HP) (yield gpm)
ELECT (type power)
 - (7) electric log NO
(yes or no)
 - (organization running log)
 - (8) how well bottom plugged WOOD


CODED

DRILLERS REMARKS:

SEE 15 1973

If well telescopes please sketch and show depths.

GROUND LEVEL

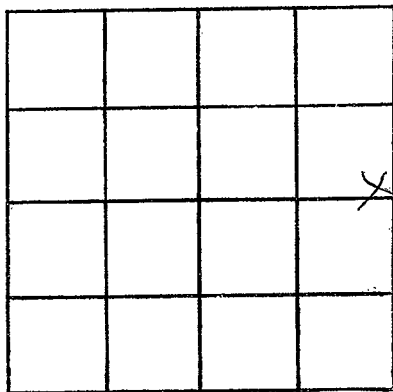

SECTION 26

Please indicate well location X.

ADDITIONAL INFORMATION

If more than one screen, show locations of each on sketch.