

MISSISSIPPI  
 BOARD OF WATER COMMISSIONERS  
 416 North State Street  
 Jackson, Mississippi 39201

**CODED**

WATER WELL DRILLERS LOG

MONROE  
 M 25  
 12-21-72

12-21 1972 date well completed W. J. REEVES, Sr. firm name MONROE county well located

LANDOWNER: WOODIE MURFF  
HAMILTON

description of formations encountered	from	to
RD CLAY	0	16
RD SAND	16	54
BOUE CLAY	84	86

(mailing address)

WELL LOCATION:  
 sec. 33 T. 14 N. R. 18 E. S. 5  
6 miles SE of ABERDEEN  
 (distance) (direction) (nearest town)

WELL PURPOSE: HOME  
 (home, irrigation, municipal, industrial)

- WELL COMPLETION DATA:
- diameter (inches) 4
  - total depth (feet) 86
  - static water level (feet) 46 below above top of ground.
  - casing PVC, 66 (material), (depth)  
4 (size) if telescope see back.
  - screen 20, 46 (length), (depth to top)  
4 (size), PVC (material)
  - pump 1/2, 10 (HP), (yield gpm)  
ELECT (type power)
  - electric log No (yes or no)  
 (organization running log)
  - how well bottom plugged WOOD


**CODED**

DRILLERS REMARKS:

SEP 15 1973

If well telescopes please sketch and show depths.

GROUND LEVEL

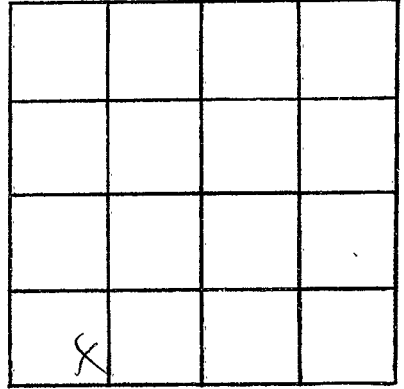

SECTION S.3

Please indicate well location X.

ADDITIONAL INFORMATION.

If more than one screen, show locations of each on sketch.