

MONROE
M 26
12-28-72

MISSISSIPPI
 BOARD OF WATER COMMISSIONERS
 416 North State Street
 Jackson, Mississippi 39201

WATER WELL DRILLERS LOG **CODED**

12-28 1972 W. J. REEVES & SON MONROE
 date well completed firm name county well located

LANDOWNER: ROBT. HOLDINGS
RT. 2
ABERDEEN
 (mailing address)

| description of formations encountered | from | to |
|---------------------------------------|-------------|-----------|
| | <u>CLAY</u> | <u>0</u> |
| <u>SAND & GRAVEL</u> | <u>21</u> | <u>52</u> |

WELL LOCATION:
 sec. 7 T. 14 R. 10
6 miles NE of ABERDEEN
 (distance) (direction) (nearest town)

WELL PURPOSE: HOME
 (home, irrigation, municipal, industrial)

- WELL COMPLETION DATA:
- (1) diameter (inches) 4
 - (2) total depth (feet) 50
 - (3) static water level (feet) 20 below top of ground.
 - (4) casing PVC 30,
 (material) (depth)
4 if telescope see back.
 (size)
 - (5) screen 20 30
 (length) (depth to top)
4 PVC
 (size) (material)
 - (6) pump 1/2 10
 (HP) (yield gpm)
ELECT
 (type power)
 - (7) electric log NO
 (yes or no)
 - (organization running log)
 - (8) how well bottom plugged WOOD


CODED

FEB 15 1973

DRILLERS REMARKS:

If well telescopes please sketch and show depths.

GROUND LEVEL

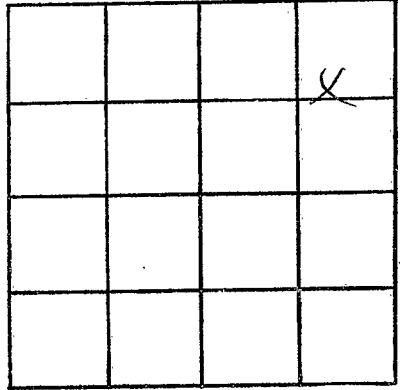

SECTION 2

Please indicate well location X.

ADDITIONAL INFORMATION

If more than one screen,
show locations of each on sketch.