

MISSISSIPPI
BOARD OF WATER COMMISSIONERS
416 North State Street
Jackson, Mississippi 39201

CODED

WATER WELL DRILLERS LOG

MONROE
MZT
4-8-73

April 8~~th~~ & 10 1973 J. W. Webb & Sons Monroe
date well completed firm name county well located


LANDOWNER: <u>H. D. Moffatt</u> <u>Rt 2</u>	description of formations encountered	from	to
<u>Aberdeen Miss</u> (mailing address)	<u>top soil</u> <u>sand & gravel</u>	<u>0</u> <u>2</u>	<u>2</u> <u>29</u>
<p>WELL LOCATION: sec <u>24</u> T <u>14</u> N R <u>8</u> E <u>15</u> miles <u>E</u> of <u>Aberdeen</u> (distance) (direction) (nearest town)</p>			
<p>WELL PURPOSE: <u>home</u> (home, irrigation, municipal, industrial)</p>			
<p>WELL COMPLETION DATA:</p>			
<p>(1) diameter (inches) <u>4"</u></p>			
<p>(2) total depth (feet) <u>29 ft</u></p>			
<p>(3) static water level (feet) <u>4'</u> <u>below</u> above top of ground.</p>			
<p>(4) casing <u>plastic</u>, <u>29 ft</u> (material) (depth)</p>			
<p><u>4"</u> (size) if telescope see back.</p>			
<p>(5) screen _____ (length) (depth to top) (size) (material)</p>			
<p>(6) pump <u>1/2</u> (HP) _____ (yield gpm) (type power)</p>			
<p>(7) electric log <u>no</u> (yes or no)</p>			
<p>(organization running log)</p>			
<p>(8) how well bottom plugged <u>cased to bottom</u></p>			
<p>DRILLERS REMARKS: <u>dilled 2 wells same location log reflects both wells</u></p>			

CODED

JUN 11 1973

If well telescopes please sketch and show depths.

GROUND LEVEL

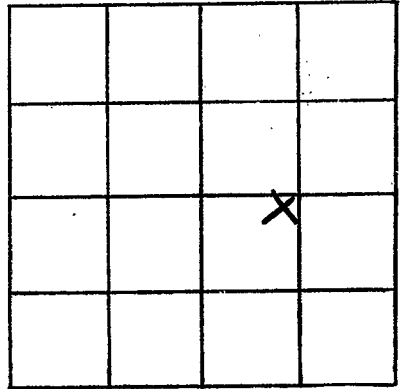

SECTION 24

Please indicate well location X.

ADDITIONAL INFORMATION

If more than one screen,
show locations of each on sketch.