

MISSISSIPPI  
 BOARD OF WATER COMMISSIONERS  
 416 North State Street  
 Jackson, Mississippi 39201

**CODED**

MONROE  
M28  
4-1-23

WATER WELL DRILLERS LOG

April 1 1923 J. W. Webb & Sons Monroe  
 date well completed firm name county well located

LANDOWNER: Robert H. Leup  
R#2  
Aberdeen Miss  
 (mailing address)

description of formations encountered	from	to
	<u>top soil</u>	<u>0</u>
<u>sand &amp; gravel</u>	<u>2</u>	<u>30</u>

WELL LOCATION:  
 sec 24 T 14 N 18 R 2 E  
15 miles E of Aberdeen  
 (distance) (direction) (nearest town)

WELL PURPOSE: home  
 (home, irrigation, municipal, industrial)

- WELL COMPLETION DATA:
- (1) diameter (inches) 4"
  - (2) total depth (feet) 30 ft
  - (3) static water level (feet) 12 below above top of ground.
  - (4) casing plastic 30 ft  
 (material) (depth)  
4"  
 (size) If telescope see back.
  - (5) screen \_\_\_\_\_  
 (length) (depth to top)  
 \_\_\_\_\_  
 (size) (material)
  - (6) pump 0  
 (HP) (yield gpm)  
 \_\_\_\_\_  
 (type power)
  - (7) electric log NO  
 (yes or no)  
 \_\_\_\_\_  
 (organization running log)
  - (8) how well bottom plugged cased to bottom


**CODED**

DRILLERS REMARKS: \_\_\_\_\_

JUN 17 1923

If well telescopes please sketch and show depths.

GROUND LEVEL

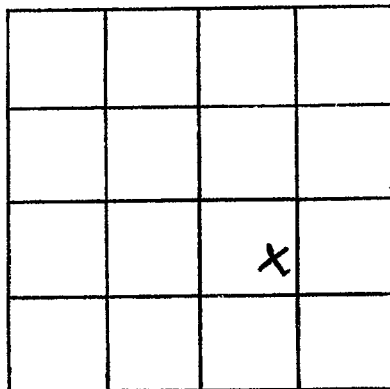

SECTION 24

Please indicate well location X.

ADDITIONAL INFORMATION

If more than one screen, show locations of each on sketch.