

MONROE

M 5429

7-12-73

MISSISSIPPI BOARD OF WATER COMMISSIONERS
416 North State Street
Jackson, Mississippi 39201

CODED

WATER WELL DRILLERS LOG

7-12 1973 W. J. REEVES 2 SON MON ROE
date well completed firm name county well located

LANDOWNER: JAMES MIZE

RT. 2

ABERDEEN

(mailing address)

description of formations encountered

from

to

CLAY 0 18
RED SAND 18 78
BLUE CLAY 78 80

WELL LOCATION:

sec. B T 14 R 18
S W
8 miles SE of AMORY
(distance) (direction) (nearest town)

WELL PURPOSE: HOME
(home, irrigation, municipal, industrial)

WELL COMPLETION DATA:

- (1) diameter (inches) 4
- (2) total depth (feet) 80
- (3) static water level (feet) 20 below above top of ground.
- (4) casing PVC, 60
(material) (depth)
4 if telescope see back.
(size)
- (5) screen 20, 60
(length) (depth to top)
4, PVC
(size) (material)
- (6) pump 1/2, 10
(HP) (yield gpm)
ELECT
(type power)
- (7) electric log NO
(yes or no)

(organization running log)
- (8) how well bottom plugged WOOD

CODED


DRILLERS REMARKS:

NOV 30 1973

MISS. BD. OF WATER COMMISSIONERS

If well telescopes please
sketch and show depths.

GROUND LEVEL

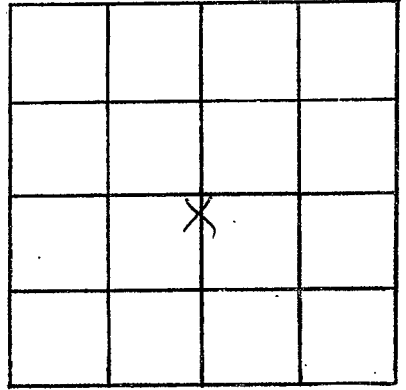

SECTION 5

Please indicate well location X.

ADDITIONAL INFORMATION

If more than one screen,
show locations of each on sketch.