

MONROE

M 30

2-6-74

MISSISSIPPI  
 BOARD OF WATER COMMISSIONERS  
 416 North State Street  
 Jackson, Mississippi 39201

CODED

WATER WELL DRILLERS LOG

2-6

19

W.S. REEVES 2 SON

MONROE

date well completed

firm name

county well located

LANDOWNER: CLARENCE COSA

description of fomations encountered

from

to

RT. 2

ABERDEEN

(mailing address)

CLAY  
RED SAND  
BLUE CLAY

0 23  
23 90  
90 93

WELL LOCATION:

sec. 14 T 14 N R. 18 E  
 S W  
 8 miles E of ABERDEEN  
 (distance) (direction) (nearest town)

WELL PURPOSE: HOME (home, irrigation, municipal, industrial)

WELL COMPLETION DATA:


- (1) diameter (inches) 4
- (2) total depth (feet) 93
- (3) static water level (feet) 50 below above top of ground.
- (4) casing PVC, 73 (material) (depth)  
 4 (size) If telescope see back.
- (5) screen 20, 73 (length) (depth to top)  
 4, PVC (size) (material)
- (6) pump 1/2, 10 (HP) (yield gpm)  
 ELECT (type power)
- (7) electric log NO (yes or no)

(organization running log)

(8) how well bottom plugged SAND

DRILLERS REMARKS:


CODED

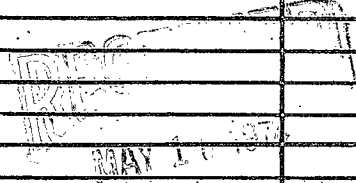

MISS. BD. OF WATER COMMISSIONERS

If well telescopes please sketch and show depths.

GROUND LEVEL

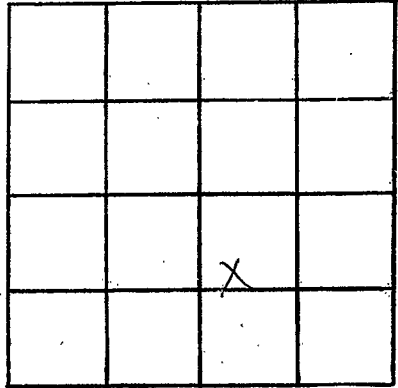

SECTION 14

Please indicate well location X.

ADDITIONAL INFORMATION

If more than one screen, show locations of each on sketch.