

MONROE

M31

4-30-74

MISSISSIPPI BOARD OF WATER COMMISSIONERS
416 North State Street
Jackson, Mississippi 39201

CODED

WATER WELL DRILLERS LOG

4-30
date well completed

1974 W. J. REEDS 2 SON
firm name

MONROE
county well located

LANDOWNER: MONROE COUNTY

SANITARY LAND FILL

ABERDEEN

(mailing address)

WELL LOCATION:

sec. 14 T. 14 N. S.

R. 18 W.

8 miles E of ABERDEEN
(distance) (direction) (nearest town)

WELL PURPOSE:

(home, irrigation, municipal, industrial)

WELL COMPLETION DATA:

- (1) diameter (inches) 4
- (2) total depth (feet) 240
- (3) static water level (feet) 132 below top of ground.

- (4) casing PVC, 220 (material) (depth)

4 (size) if telescope see back.

- (5) screen 20, 220 (length) (depth to top)

4, PVC (size) (material)

- (6) pump 1, 15 (HP) (yield gpm)

ELECT (type power)

- (7) electric log No (yes or no)

(organization running log)

- (8) how well bottom plugged SAND

description of formations encountered

from

to


CLAY	0	20
RED SAND	24	75
SANDY BLUE CLAY	75	185
BLUE CLAY	185	215
GRAY SAND	215	240

CODED

DRILLERS REMARKS:

If well telescopes please sketch and show depths.

GROUND LEVEL

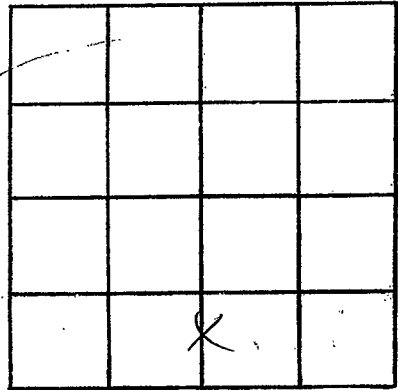

SECTION 14

Please indicate well location X.

ADDITIONAL INFORMATION

If more than one screen,
show locations of each on sketch.