

MONROE  
M32  
8/26/74

MISSISSIPPI  
BOARD OF WATER COMMISSIONERS  
416 North State Street  
Jackson, Mississippi 39201

WATER WELL DRILLERS LOG **CODED**

8-26 1974 W. J. REEVES & SON MONROE  
date well completed firm name county well located

LANDOWNER: R.D. COVINGTON RT. 2	description of formations encountered	from	to
ABERDEEN (mailing address)			
	RED SAND	18	100
WELL LOCATION: sec. 14 T 14 R 18 8 miles E of ABERDEEN (distance) (direction) (nearest town)			
WELL PURPOSE: HOME (home, irrigation, municipal, industrial)			
WELL COMPLETION DATA:			
(1) diameter (inches) 4			
(2) total depth (feet) 100			
(3) static water level (feet) 50 below top of ground.			
(4) casing PVC, 80 (material) (depth) 4 (size) If telescope see back.			
(5) screen 20, 80 (length) (depth to top) 4, PVC (size) (material)			
(6) pump 3/4, 10 (HP) (yield gpm) ELECT (type power)			
(7) electric log NO (yes or no)			
(organization running log)			
(8) how well bottom plugged SAND			
DRILLERS REMARKS:			


**CODED**

MISSISSIPPI  
BOARD OF WATER COMMISSIONERS  
AUG 26 1974

MISS. RD. OF WA. COMM

If well telescopes please sketch and show depths.

GROUND LEVEL

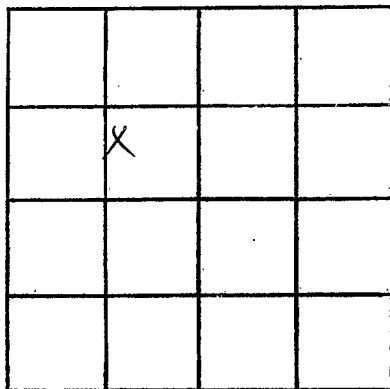

SECTION 14

Please indicate well location X.

ADDITIONAL INFORMATION

If more than one screen,  
show locations of each on sketch.