

MONROE
 N 7 M 36
 3-22-69

MISSISSIPPI
 BOARD OF WATER COMMISSIONERS
 416 North State Street
 Jackson, Mississippi 39201

CODED

WATER WELL DRILLERS LOG

3-22 1969 W. J. REEVES & SON MONROE
 date well completed firm name county well located

LANDOWNER: NEW PROSPECT CHURCH

Description of formations encountered	from	to
HAMILTON		
RED CLAY	0	25
SAND & GRAVEL	25	37
BLUE CLAY	37	49
RED SAND	49	86
RED SAND & CLAY STRKS	86	110
BLUE CLAY	110	113
		7

HAMILTON

(mailing address)

WELL LOCATION: 18
 sec. 28 T 14 S R 12 W
 6 miles E of ABERDEEN
 (distance) (direction) (nearest town)

WELL PURPOSE: CHURCH
 (home, irrigation, municipal, industrial)

WELL COMPLETION DATA:

- (1) diameter (inches) 4
- (2) total depth (feet) 113
- (3) static water level (feet) 75 below top of ground.
- (4) casing PVC, 93 (material), (depth)
 4 (size) if telescope see back.
- (5) screen 20, 93 (length), (depth to top)
 4, PVC (size), (material)
- (6) pump 3/4 (HP), 6 (yield gpm)
 ELECT (type power)
- (7) electric log NO (yes or no)
 (organization running log)
- (8) how well bottom plugged SAND

ELW - 340'


DRILLERS REMARKS:

JUN 28 1969

MISS. Bd. OF
 WATER COMM.

If well telescopes please sketch and show depths.

GROUND LEVEL

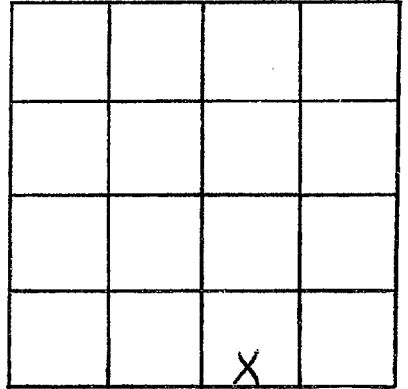

SECTION 28

Please indicate well location X.

ADDITIONAL INFORMATION

If more than one screen, show locations of each on sketch.