

Monroe  
M 2009  
6-19-75

MISSISSIPPI  
 BOARD OF WATER COMMISSIONERS  
 416 North State Street  
 Jackson, Mississippi 39201

WATER WELL DRILLERS LOG

6-19 1975 W.S. REEVES & SON MONROE  
 date well completed firm name county well located

LANDOWNER: H.R. TUCKER  
RT. 2  
ABERDEEN  
 (mailing address)

description of formations encountered	from	to
<u>RED CLAY</u>	<u>0</u>	<u>24</u>
<u>" SAND</u>	<u>24</u>	<u>85</u>
<u>BLUE CLAY</u>	<u>85</u>	<u>87</u>
<u>WHITE SAND</u>	<u>87</u>	<u>100</u>

WELL LOCATION: 13L  
 sec 25 T 14 S R 10 E W  
10 miles E of ABERDEEN  
 (distance) (direction) (nearest town)

WELL PURPOSE: HOME  
 (home, irrigation, municipal, industrial)


- WELL COMPLETION DATA:
- (1) diameter (inches) 4
  - (2) total depth (feet) 100
  - (3) static water level (feet) 35 below top of ground.
  - (4) casing PVC, 80  
 (material) (depth)  
4 if telescope see back.  
 (size)
  - (5) screen 20, 80  
 (length) (depth to top)  
4 PVC  
 (size) (material)
  - (6) pump 1/2 10  
 (HP) (yield gpm)  
ELECT  
 (type power)
  - (7) electric log No  
 (yes or no)
  - (organization running log)
  - (8) how well bottom plugged SAND

DRILLERS REMARKS: NOV 28 1975

MISSISSIPPI  
NOV 28 1975  
MISS BE

If well telescopes please sketch and show depths.

GROUND LEVEL

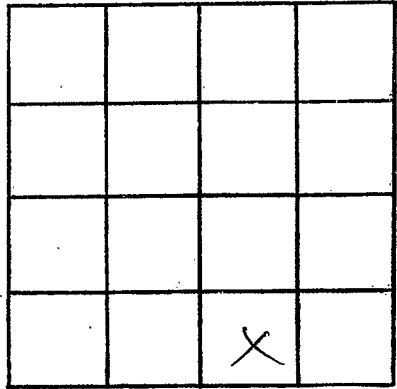

SECTION 25

Please indicate well location X.

ADDITIONAL INFORMATION

If more than one screen,  
show locations of each on sketch.