

MONROE

M 2001

3-7-77

MISSISSIPPI
 BOARD OF WATER COMMISSIONERS
 416 North State Street
 136 Jackson, Mississippi 39201

WATER WELL DRILLERS LOG

3-7-77 date well completed

1977 MID SOUTH DRILLING firm name

Monroe county well located

LANDOWNER: James Walters
Aberdeen, Miss.

description of formations encountered

from to

red clay	0	12
sand	12	35
clay of sand streaks	35	71
rock	71	72
band of clay	72	133
clay	133	135
sand	135	140

(mailing address)

WELL LOCATION:

sec 28 T. 14 N. R. 18 E. S. 1
1/2 miles East of Sockey, Miss.
(distance) (direction) (nearest town)

WELL PURPOSE: Home
(home, irrigation, municipal, industrial)

WELL COMPLETION DATA:

- (1) diameter (inches) 4"
- (2) total depth (feet) 144'
- (3) static water level (feet) 50 below top of ground.
- (4) casing PVC, 144' (material), (depth)
(size) if telescope see back.
- (5) screen 10' length, 134' depth to top (material) PVC (size)
- (6) pump 1/2 HP, 7 yield gpm (type power) E
- (7) electric log (yes or no)
(organization running log)
- (8) how well bottom plugged

RECEIVED


JUN 18 1977

MISS. BD. OF WATER COMMISSIONERS

DRILLERS REMARKS:

If well telescopes please sketch and show depths.

GROUND LEVEL

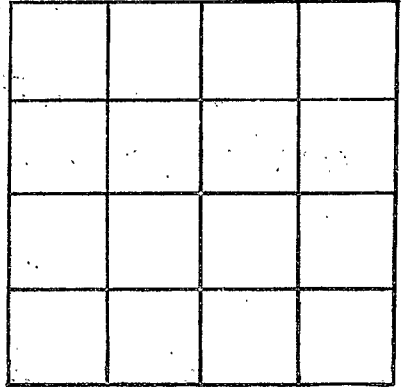

SECTION _____

Please indicate well location X.

ADDITIONAL INFORMATION

If more than one screen, show locations of each on sketch.