

MONROE

M 2002

12/9/77

MISSISSIPPI BOARD OF WATER COMMISSIONERS
416 North State Street
Jackson, Mississippi 39201

WATER WELL DRILLERS LOG

12-9-77 date well completed 1977 W.J. REEVES & SON firm name MONROE county well located

LANDOWNER: WAYNE VINES

RT. 4 Box 103A

ABERDEEN

(mailing address)

description of formations encountered

from

to

RED CLAY

0 38

SAND

38 138

BLUE CLAY

138 140

WELL LOCATION:

sec. 27 T. 14 S. R. 18 E. W. 7 miles E of ABERDEEN
(distance) (direction) (nearest town)

WELL PURPOSE: HOME
(home, irrigation, municipal, industrial)

WELL COMPLETION DATA:

- (1) diameter (inches) 4
- (2) total depth (feet) 140
- (3) static water level (feet) 102 below top of ground.
- (4) casing PVC 120 (material) (depth)
4 (size) if telescope see back.
- (5) screen 20 120 (length) (depth to top)
4 (size) PVC (material)
- (6) pump 1/2 10 (HP) (yield gpm)
ELECT (type power)
- (7) electric log NO (yes or no)

(organization running log)

(8) how well bottom plugged WOOD

DRILLERS REMARKS:


RECEIVED

APR 18 1978

MISS. BD. OF WATER COMM.

If well telescopes please sketch and show depths.

GROUND LEVEL

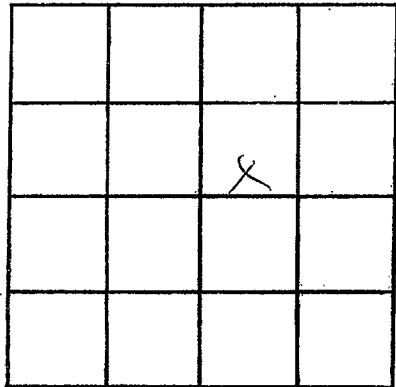

SECTION 27

Please indicate well location X.

ADDITIONAL INFORMATION

A series of horizontal lines for writing additional information.

If more than one screen, show locations of each on sketch.