

MONROE
M 2003
6-9-78

**MISSISSIPPI
BOARD OF WATER COMMISSIONERS**
416 North State Street
Jackson, Mississippi 39201

WATER WELL DRILLERS LOG

6-9 1978 Leiper Monroe
 date well completed firm name county well located

LANDOWNER: Christian Bradley
Rt. 2 Box 305
Hamilton, Ms.
 (mailing address)

description of formations encountered	from	to
<u>Top sand & clay</u>	<u>0</u>	<u>80</u>
<u>Blue clay</u>	<u>80</u>	<u>100</u>
<u>sand</u>	<u>100</u>	<u>113</u>

WELL LOCATION:
 sec. 3 T 15 N R 18 E
5 miles NE of Lacey
 (distance) (direction) (nearest town)

WELL PURPOSE: Home
 (home, irrigation, municipal, industrial)

- WELL COMPLETION DATA:
- (1) diameter (inches) 4
 - (2) total depth (feet) 113
 - (3) static water level (feet) 100 ^{below} top of ground.
 - (4) casing PVC, 103
 (material) (depth)
 - _____ if telescope see back.
 (size)
 - (5) screen 10, _____
 (length) (depth to top)
 - 4, PVC
 (size) (material)
 - (6) pump 3/4, 4
 (HP) (yield gpm)
 - Elec
 (type power)
 - (7) electric log No
 (yes or no)
 - _____ (organization running log)
 - (8) how well bottom plugged back
wash valve


RECEIVED
 SEP 14 1978

DRILLERS REMARKS:

MISS. BD. OF WATER COMMISSIONERS

If well telescopes please sketch and show depths.

GROUND LEVEL

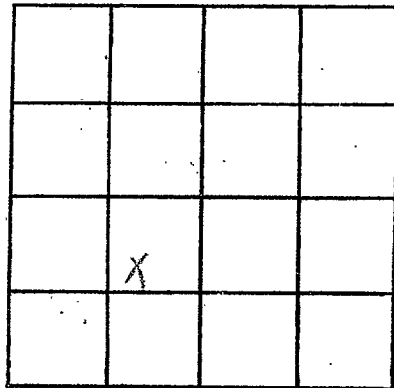

SECTION 3

Please indicate well location X.

ADDITIONAL INFORMATION

If more than one screen,
show locations of each on sketch.