

MISSISSIPPI DEPARTMENT OF NATURAL RESOURCES

Bureau of Land and Water Resources

P.O. Box 10631

Jackson, Mississippi 39209

WATER WELL DRILLERS LOG

COUNTY WELL LOCATED <i>Monroe</i>	
WELL NUMBER <i>M 2005</i>	CODED
DATE WELL COMPLETED <i>11-5-87</i>	

PERMIT NUMBER <i>N/A</i>
NAME OF DRILLING FIRM <i>Hendrix Well Supply</i>
<i>Shannon, Mo.</i>

NAME & MAILING ADDRESS OF LANDOWNER <i>J. W. Brewer</i>			
<i>Rt. 4 Box 35A</i>			
<i>Aberdeen</i>			
WELL LOCATION:	SEC <i>31</i>	TOWNSHIP <i>T14 N</i>	RANGE <i>R18 E</i>
DISTANCE <i>3</i>	DIRECTION <i>south</i>	NEAREST TOWN <i>Becker</i>	
OTHER LANDMARK <i>East of Church</i>			
WELL PURPOSE: <input type="checkbox"/> Home, <input type="checkbox"/> Irrigation, <input type="checkbox"/> Municipal, <input type="checkbox"/> Industrial, <input checked="" type="checkbox"/> Fish Pond/Petc.			

PUMP DATA		
PUMP TYPE (Circle One): <input checked="" type="radio"/> Submersible <input type="radio"/> Turbine <input type="radio"/> Jet <input type="radio"/> Flowing Well, Other (Describe) <i>Customer pump</i>		
POWER TYPE (Circle One): <input checked="" type="radio"/> Electric <input type="radio"/> Tractor <input type="radio"/> Diesel <input type="radio"/> Gasoline <input type="radio"/> Butane, Other (Describe)		
Pump Capacity (GPM)	No. of Stages	Setting Depth
		FT.
PUMP TEST		
Well yielded <i>N/A</i> GPM with a drawdown of _____ ft. after _____ hours of pumping		

WELL DATA		
Well Depth <i>92'</i>	Casing Diameter (In.) <i>4"</i>	Casing Length (Ft.) <i>62'</i>
Type of Casing <i>PVC</i>	Hole Depth <i>160'</i>	Depth to Static Water Level <i>13'10"</i>
TYPE OF COMPLETION: (Circle One or More): <input checked="" type="checkbox"/> Gravel Packed, <input type="checkbox"/> Underreamed, <input type="checkbox"/> Telescoped, <input type="checkbox"/> Natural Development, <input type="checkbox"/> Open Hole, <input type="checkbox"/> Other (Describe)		
Top of Lap Pipe or Reduction in Casing		
FEET		IF TELESCOPED OR MORE THAN ONE SCREEN: USE BACK PAGE

LOG DATA	
TYPE OF LOG RUN (Circle One): <input checked="" type="radio"/> No Log Run, <input type="radio"/> Electric, <input type="radio"/> Gamma Ray, <input type="radio"/> Density, <input type="radio"/> Sonic, <input type="radio"/> Neutron, Other (Describe)	
Name of Organization Running Log	

SCREEN DATA		
Diameter - Inches <i>4"</i>	Length - Feet <i>30'</i>	Slot Size - Inches <i>10</i>
Screen Type <i>PVC</i>	Depth to Bottom - Feet <i>92</i>	

GEOLOGIC DATA (Office Use Only)			
Surface Elev.	Geologic Unit	Unit Thickness	Depth to Top
Subs. SWL	Date	Analysis	Aquifer Test
Driller's Remarks <i>Used customer casing & screen. Furnished Rig & Gravel</i>			


DESCRIPTION OF FORMATIONS ENCOUNTERED	FROM	TO	FORMATIONS (Continued)	FROM	TO
<i>sandy clay</i>	<i>0</i>	<i>5</i>	<i>sand</i>	<i>127</i>	<i>145</i>
<i>clay</i>	<i>5</i>	<i>15</i>	<i>blue rock</i>	<i>145</i>	<i>160</i>
<i>sand</i>	<i>15</i>	<i>25</i>			
<i>sandy clay</i>	<i>25</i>	<i>55</i>			
<i>sandy blue rock</i>	<i>55</i>	<i>65</i>			
<i>sandy clay</i>	<i>65</i>	<i>70</i>			
<i>blue rock</i>	<i>70</i>	<i>74</i>			
<i>sand</i>	<i>74</i>	<i>85</i>			
<i>blue rock</i>	<i>85</i>	<i>112</i>			
<i>sandy blue rock</i>	<i>112</i>	<i>116</i>			
<i>blue rock</i>	<i>116</i>	<i>137</i>			

Department of Natural Resources
Bureau of Land & Water Resources

IF MORE SPACE IS NEEDED, USE BACK

If well telescopes please sketch and show depths.

GROUND LEVEL

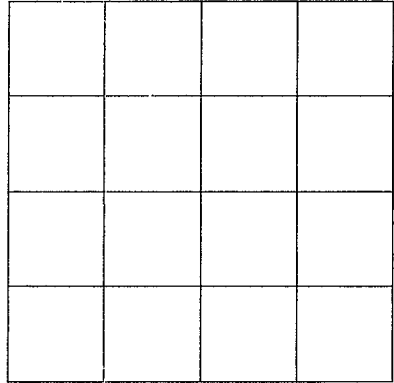

SECTION _____

Please indicate well location X.

ADDITIONAL INFORMATION

If more than one screen, show location of each on sketch.