

MISSISSIPPI DEPARTMENT OF NATURAL RESOURCES

Bureau of Land and Water Resources

P.O. Box 10631
Jackson, Mississippi 39209
WATER WELL DRILLERS LOG

COUNTY WELL LOCATED	
Includes MONROE	
WELL NUMBER	CODED
M 7	REG
DATE WELL COMPLETED	
9-14-88	

PERMIT NUMBER
01-379
NAME OF DRILLING FIRM
Mid South Drilling Co.
CITY AND STATE
Carrollton, AL 35447

NAME & MAILING ADDRESS OF LANDOWNER			
Phillip Duke			
Department of Natural Resources			
Rt. 2 Box 387-A			
And & Water Resources			
Aberdeen, MS 39730			
WELL LOCATION:	SEC	TOWNSHIP	RANGE
	27	14	18 ^N _S ^E _W
DISTANCE	DIRECTION	NEAREST TOWN	
5 1/2	Miles east	of Aberdeen	
OTHER LANDMARK			
WELL PURPOSE: Home, Irrigation, Municipal, Industrial, Fish Pond, etc.			
home			

PUMP DATA		
PUMP TYPE (Circle One):		
<input checked="" type="radio"/> Submersible	Turbine,	Jet Flowing Well,
Other (Describe) _____		
POWER TYPE (Circle One):		
<input checked="" type="radio"/> Electric	Tractor,	Diesel, Gasoline, Butane,
Other (Describe) _____		
Pump Capacity (GPM)	No. of Stages	Setting Depth
10	11	120' FT.
PUMP TEST		
Well yielded _____ 10 _____ GPM with		
a drawdown of _____ 115' _____ ft.		
after _____ 3 _____ hours of pumping		

WELL DATA		
Well Depth	Casing Diameter (In.)	Casing Length (Ft.)
132'	4"	122'
Type of Casing	Hole Depth	Depth to Static Water Level
PVC	132'	70'
TYPE OF COMPLETION: (Circle One or More):		
<input checked="" type="checkbox"/> Gravel Packed	<input type="checkbox"/> Underreamed,	<input type="checkbox"/> Telescoped,
<input type="checkbox"/> Natural Development,	<input type="checkbox"/> Open Hole,	<input type="checkbox"/> Other
(Describe) _____		
Top of Lap Pipe or Reduction in Casing		
FEET	IF TELESCOPED OR MORE THAN ONE SCREEN: USE BACK PAGE	

LOG DATA	
TYPE OF LOG RUN (Circle One):	
<input type="radio"/> Electric,	<input type="radio"/> Gamma Ray,
<input type="radio"/> Density,	<input type="radio"/> Sonic,
<input type="radio"/> Neutron,	<input checked="" type="radio"/> No Log Run
Other (Describe) _____	
Name of Organization Running Log:	


SCREEN DATA		
Diameter - Inches	Length - Feet	Slot Size - Inches
4	10'	.020
Screen Type	Depth to Bottom - Feet	
PVC	122'	

GEOLOGIC DATA (Office Use Only)			
Surface Elev.	Geologic Unit	Unit Thickness	Depth to Top
Subs. SWL	Date	Analysis	Aquifer Test
Driller's Remarks			

DESCRIPTION OF FORMATIONS ENCOUNTERED	FROM	TO	FORMATIONS (Continued)	
			FROM	TO
sand red clay	0	9	clay	62 70
clay	9	11	sand	70 90
sand	11	20	sand w/clay streaks	90 92
sand & gravel	20	30	sand	92 100
clay	30	35	sand w/clay streaks	100 112
sand	35	39	sand	112 132
clay	39	52		
sand	52	62		
IF MORE SPACE IS NEEDED, USE BACK				

If well telescopes please sketch and show depths.

GROUND LEVEL

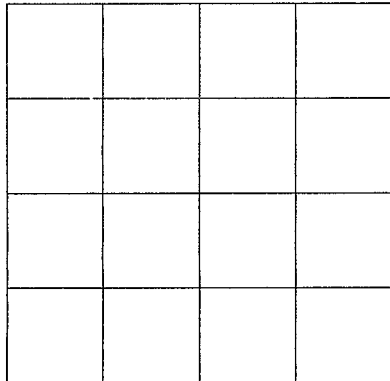

SECTION _____

Please indicate well location X.

ADDITIONAL INFORMATION

A series of horizontal lines for providing additional information.

If more than one screen, show location of each on sketch.