

MONROE
M 2007

MISSISSIPPI
BOARD OF WATER COMMISSIONERS
416 North State Street
Jackson, Mississippi 39201

WATER WELL DRILLERS LOG

11-8-88 date well completed 1988 Monroe S. Kelly firm name Monroe county well located

LANDOWNER: Kenny Davis
Rt 2
Hamilton, MS.
(mailing address)

description of formations encountered	depth	
	from	to
<u>Red sandy clay</u>	<u>0</u>	<u>60</u>


WELL LOCATION:
sec 25 T-14-N-W R-18-E-W
6 miles NE of Hamilton
(distance) (direction) (nearest town)

<u>Clay + shale</u>	<u>60</u>	<u>95</u>
<u>Sand</u>	<u>95</u>	<u>120</u>

WELL PURPOSE: Home
(home, irrigation, municipal, industrial)

- WELL COMPLETION DATA:
- (1) diameter (inches) 14"
 - (2) total depth (feet) 120'
 - (3) static water level (feet) 99 below top of ground.
 - (4) casing PVC, 120'
(material) (depth)
(size) if telescope see back.
 - (5) screen 10', 110'
(length) (depth to top)
4", PVC
(size) (material)
 - (6) pump 1/2, 6
(HP) (yield gpm)
E.
(type power)
 - (7) electric log (yes or no)
(organization running log)
 - (8) how well bottom plugged


DRILLERS REMARKS:

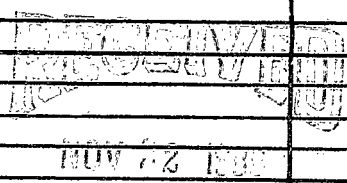

Department of Natural Resources
Section of Land & Water Resources

If well telescopes please
sketch and show depths.

GROUND LEVEL

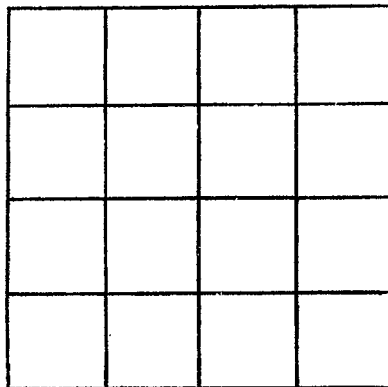

SECTION _____

Please indicate well location X.

ADDITIONAL INFORMATION

If more than one screen,
show locations of each on sketch.