

MISSISSIPPI DEPARTMENT OF NATURAL RESOURCES

Bureau of Land and Water Resources

P.O. Box 10631

Jackson, Mississippi 39209

WATER WELL DRILLERS LOG

COUNTY WELL LOCATED MONROE	
WELL NUMBER M 2008	CODED
DATE WELL COMPLETED 7/16/90	

PERMIT NUMBER
NAME OF DRILLING FIRM Rossi Drilling

NAME & MAILING ADDRESS OF LANDOWNER Mike Bucci			
Rt 21 Box 271			
Greenwood Springs MS 38944			
WELL LOCATION:	SEC	TOWNSHIP	RANGE
	9	14 S	R 8 E
DISTANCE	DIRECTION	NEAREST TOWN	
1 1/2	South	Greenwood Springs	
OTHER LANDMARK			
WELL PURPOSE: <u>Home</u> , Irrigation, Municipal, Industrial, Fish Pond, etc.			

PUMP DATA		
PUMP TYPE (Circle One): <input checked="" type="checkbox"/> Submersible Turbine, Jet, Flowing Well, Other (Describe) _____		
POWER TYPE (Circle One): <input checked="" type="checkbox"/> Electric, Tractor, Diesel, Gasoline, Butane, Other (Describe) _____ H/P 5 HP		
Pump Capacity (GPM) 30	No. of Stages	Setting Depth 265 FT.
PUMP TEST		
Well yielded _____ GPM with a drawdown of _____ ft. after _____ hours of pumping		

WELL DATA		
Well Depth 289'	Casing Diameter (In.) 4"	Casing Length (Ft.) 269'
Type of Casing PVC	Hole Depth	Depth to Static Water Level 170'
TYPE OF COMPLETION: (Circle One or More): <input checked="" type="checkbox"/> Gravel Packed, Underreamed, Telescoped, Natural Development, Open Hole, Other		
Top of Lap Pipe or Reduction in Casing		
FEET		IF TELESCOPED OR MORE THAN ONE SCREEN: USE BACK PAGE

LOG DATA	
TYPE OF LOG RUN (Circle One): No Log Run, Electric, Gamma Ray, Density, Sonic, Neutron, Other (Describe) None	
Name of Organization Running Log	


SCREEN DATA		
Diameter - Inches 4"	Length - Feet 20'	Slot Size - Inches .013
Screen Type 5 Slotted PVC		Depth to Bottom - Feet 289

GEOLOGIC DATA (Office Use Only)			
Surface Elev.	Geologic Unit	Unit Thickness	Depth to Top
Subs. SWL	Date	Analysis	Aquifer Test
Driller's Remarks			

DESCRIPTION OF FORMATIONS ENCOUNTERED	FROM	TO	FORMATIONS (Continued)	FROM	TO
Blue	0	68	<div style="border: 2px solid black; padding: 5px; display: inline-block;"> RECEIVED JUN 28 1991 </div>		
Light Green	68	75			
Blue Clay	75	180			
Sandy Clay Shale	180	289			
Dept. of Environmental Quality Bureau of Land & Water Resources					
IF MORE SPACE IS NEEDED, USE BACK					

If well telescopes please sketch and show depths.

GROUND LEVEL

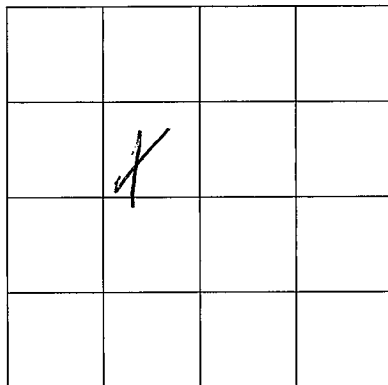

SECTION 9

Please indicate well location X.

ADDITIONAL INFORMATION

If more than one screen,
show location of each on sketch.