

MONROE
N
1-31-74

MISSISSIPPI
 BOARD OF WATER COMMISSIONERS
 416 North State Street
 Jackson, Mississippi 39201

CODED

WATER WELL DRILLERS LOG

1-31 1974 W. J. REEVES & SON MONROE
 date well completed firm name county well located

LANDOWNER: WALTER CARTER
GREENWOOD SPRINGS
 (mailing address)

description of formations encountered	from	to
CLAY	0	18
RED SAND	18	150
BLUE CLAY	150	153

WELL LOCATION:
 sec. 4 T. 14 N. R. 17 E
 S W
10 miles SE of AMORY
 (distance) (direction) (nearest town)

WELL PURPOSE: HOME
 (home, irrigation, municipal, industrial)

- WELL COMPLETION DATA:
- (1) diameter (inches) 4
 - (2) total depth (feet) 152
 - (3) static water level (feet) 96 below/above top of ground.
 - (4) casing PVC, 132,
 (material) (depth)
4 If telescope see back.
 (size)
 - (5) screen 20, 132
 (length) (depth to top)
4, PVC
 (size) (material)
 - (6) pump 1/2, 8
 (HP) (yield gpm)
ELECT
 (type power)
 - (7) electric log NO
 (yes or no)
 - (organization running log)
 - (8) how well bottom plugged SAND

CODED


DRILLERS REMARKS:

RECEIVED
 MAY 2 1974

MISS. BD. OF WATER COMMISSIONERS

If well telescopes please sketch and show depths.

GROUND LEVEL

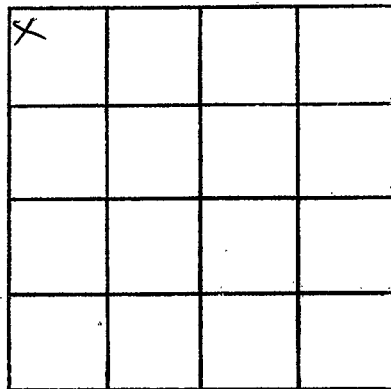

SECTION 4

Please indicate well location X.

ADDITIONAL INFORMATION

If more than one screen,
show locations of each on sketch.