

MONROE

N 6

3-20-69

MISSISSIPPI
 BOARD OF WATER COMMISSIONERS
 416 North State Street
 Jackson, Mississippi 39201

CODED

WATER WELL DRILLERS LOG

3-20 1969 date well completed

W. S. REEVES & SON firm name

MONROE county well located

LANDOWNER: LEO B. PICKUE

Rt. 2

HAMILTON

(mailing address)

description of formations encountered	from	to
	RED CLAY	0
" SAND	19	90
BLUE CLAY	90	92

WELL LOCATION:

sec. 33 T 14 N R. 10 W
 S W
6 miles SE of ABERDEEN
 (distance) (direction) (nearest town)

WELL PURPOSE: HOME
 (home, irrigation, municipal, industrial)

WELL COMPLETION DATA:

- (1) diameter (inches) 4
- (2) total depth (feet) 92
- (3) static water level (feet) 47 below top of ground.
- (4) casing PVC, 72 (material), (depth),
4 if telescope see back. (size)
- (5) screen 20, 72 (length), (depth to top)
4, PVC (size), (material)
- (6) pump 1/2, 10 (HP), (yield gpm)
ELECT (type power)
- (7) electric log N (yes or no)

(organization running log)

(8) how well bottom plugged SAND


DRILLERS REMARKS:

JUN 23 1969

MISS. Bd. of WATER COMMISSIONERS

If well telescopes please sketch and show depths.

GROUND LEVEL

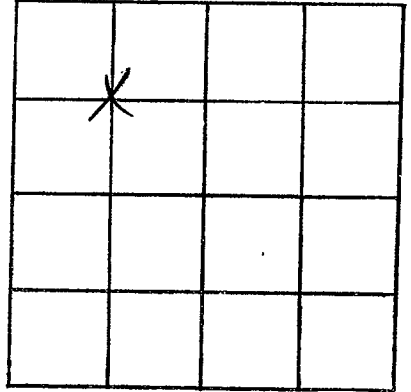

SECTION 33

Please indicate well location X.

ADDITIONAL INFORMATION

If more than one screen, show locations of each on sketch.