

MONROE  
 N 9  
 6-26-70

MISSISSIPPI  
 BOARD OF WATER COMMISSIONERS  
 416 North State Street  
 Jackson, Mississippi 39201

**CODED**

WATER WELL DRILLERS LOG

6-26 1970 U. J. REEVES & SON MONROE  
 date well completed firm name county well located

LANDOWNER: GROVER EVANS

PT. 2

ABERDEEN  
 (mailing address)

description of formations encountered	from	to
RED CLAY	0	24
RED SAND	24	109
BLUE CLAY	109	111

WELL LOCATION:

sec. 7 T. 14 S. R. 9 E  
 10 miles NE of ABERDEEN  
 (distance) (direction) (nearest town)

WELL PURPOSE: HOME  
 (home, irrigation, municipal, industrial)

WELL COMPLETION DATA:

- (1) diameter (inches) 4
- (2) total depth (feet) 111
- (3) static water level (feet) 75 below top of ground.
- (4) casing PVC 91 (material) (depth)  
 4 (size) if telescope see back.
- (5) screen 20 91 (length) (depth to top)  
 4 PVC (size) (material)
- (6) pump 1/2 10 (HP) (yield gpm)  
 ELECT (type power)
- (7) electric log NO (yes or no)

**CODED**

(organization running log)

(8) how well bottom plugged SAND


AUG 26 1970

DRILLERS REMARKS:

MISS. BD. OF  
 WATER COMING.

If well telescopes please sketch and show depths.

GROUND LEVEL

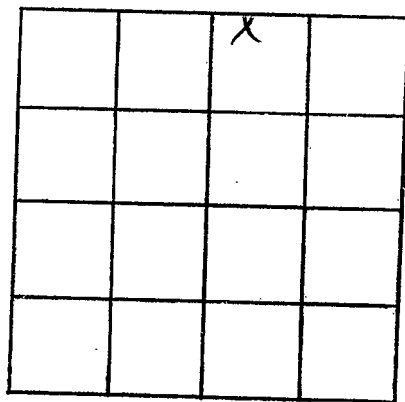

SECTION 7

Please indicate well location X.

ADDITIONAL INFORMATION

If more than one screen, show locations of each on sketch.