

MONROE

N 7 1/2

7-17-73

MISSISSIPPI  
 BOARD OF WATER COMMISSIONERS  
 416 North State Street  
 Jackson, Mississippi 39201

CODED

WATER WELL DRILLERS LOG

7-17 1973  
date well completed

W. J. REEVES & SON  
firm name

MONROE  
county well located

LANDOWNER: H. C. AUDON

RT. 2

ABERDEEN

(mailing address)

description of formations encountered

from

to

RED CLAY

0

24

" SAND

24

88

BOVE CLAY

88

90

WELL LOCATION:

sec. 7 T 14 N R. 17 E  
 S W  
10 miles SE of AMORY  
 (distance) (direction) (nearest town)

WELL PURPOSE: HOME  
 (home, irrigation, municipal, industrial)

WELL COMPLETION DATA:

- (1) diameter (inches) 4
- (2) total depth (feet) 90
- (3) static water level (feet) 50 below above top of ground.
- (4) casing PVC, 70,  
 (material) (depth)  
4 if telescope see back.  
 (size)
- (5) screen 20, 70  
 (length) (depth to top)  
4, PVC  
 (size) (material)
- (6) pump 1/2, 8  
 (HP) (yield gpm)  
EL  
 (type power)
- (7) electric log NO  
 (yes or no)  
 (organization running log)
- (8) how well bottom plugged WOOD

CODED


DRILLERS REMARKS:

OCT 20 1973

MISS. BD. OF WATER COMMISSIONERS

If well telescopes please  
sketch and show depths.

GROUND LEVEL

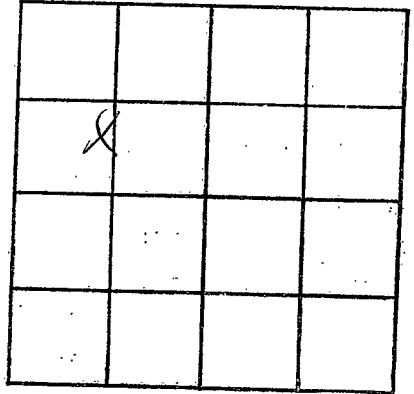

SECTION 7

Please indicate well location X.

ADDITIONAL INFORMATION

If more than one screen,  
show locations of each on sketch.