

MISSISSIPPI DEPARTMENT OF NATURAL RESOURCES

Bureau of Land and Water Resources

Southport Mall

P.O. Box 10631

Jackson, Mississippi 39209

WATER WELL DRILLERS LOG

TOM GRIFFITH

PLUMBING & WELL SERVICE, INC.
firm name

Monroe county well located

MONROE
N12
10/11/82

10/11/82 date well completed

LANDOWNER: Prust Production

description of formations encountered from to

No. 1 Holloman 26-16
Williamson
(mailing address)

Sand - Chack	1	100
Sand	100	320
Chack	320	350
bravel	350	460

WELL LOCATION:

sec 11 T 14 N R 17 E
5 miles S 5 W
(distance) (direction) (nearest town)
Caledonia

WELL PURPOSE: oil location
(home, irrigation, municipal, industrial)

WELL COMPLETION DATA:

- (1) diameter (inches) 3"
- (2) total depth (feet) 460'
- (3) static water level (feet) 150' below above top of ground.
- (4) casing steel 78C 400'
(material) (depth)
- (5) screen 60' 400'
(length) (depth to top)
- (6) pump 3" steel 78C
(size) (material)
- (7) pump new 1/2 85
(HP) (yield gpm)
- (8) electric log n/a
(type power)
- (9) electric log no
(yes or no)
- (10) n/a
(organization running log)
- (11) how well bottom plugged welded plug

1550'S E 1500' W of
VE log

CODED

MISSISSIPPI DEPARTMENT OF NATURAL RESOURCES
BUREAU OF LAND & WATER RESOURCES


JAN 28 1983

RECEIVED

DRILLERS REMARKS:

If well telescopes please sketch and show depths.

GROUND LEVEL

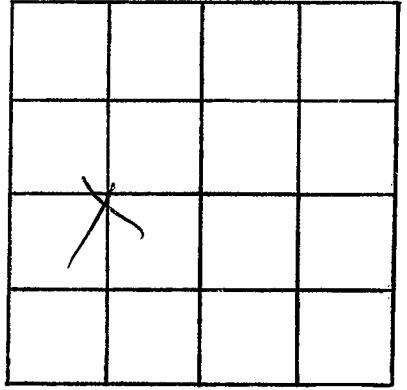

SECTION 11

Please indicate well location X.

ADDITIONAL INFORMATION

If more than one screen, show locations of each on sketch.