

MISSISSIPPI DEPARTMENT OF NATURAL RESOURCES

Bureau of Land and Water Resources

Southport Mall

P.O. Box 10631

Jackson, Mississippi 39209

WATER WELL DRILLERS LOG

CODED

MONROE
N 13

Monroe

10-4-84 date well completed Griner Drilling Service, Inc. firm name Monroe county well located

LANDOWNER:
Pruett Production Co.
217 West Capital
Suite 201
Jackson, Ms. 39201
(mailing address)

description of formations encountered from to
clay, rock, breaks 0 340
OF SAND

WELL LOCATION: 1642' N & 330' W
sec 30 T 14 N R 17 E SE 1/4
No. 1 CCC
Inc. Wise Gap Field
(distance) (direction) (nearest town)

CODED

WELL PURPOSE: oilfield supply
(home, irrigation, municipal, industrial)

WELL COMPLETION DATA:

- (1) diameter (inches) 3"
- (2) total depth (feet) 340'
- (3) static water level (feet) 25' ^{below} above top of ground.
- (4) casing steel 252'
(material) (depth)
3" If telescope see back.
(size)
- (5) screen open ended
(length) (depth to top)
(size) (material)
- (6) pump 80
(HP) (yield gpm)
AC
(type power)
- (7) electric log (yes) (no)

DEPT. OF NATURAL RESOURCES
BUREAU OF LAND & WATER RESOURCES

(organization running log)

(8) how well bottom plugged orange
peel


OCT 22 1984

RECEIVED

DRILLERS REMARKS:

If well telescopes please sketch and show depths.

GROUND LEVEL

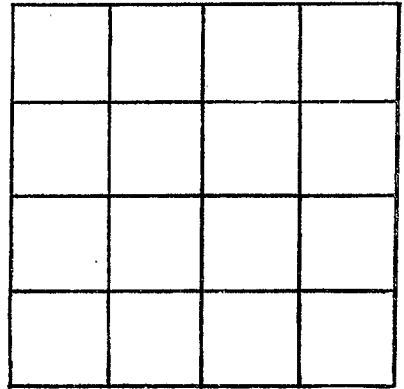

SECTION _____

Please indicate well location X.

ADDITIONAL INFORMATION

If more than one screen,
show locations of each on sketch.