

MISSISSIPPI DEPARTMENT OF NATURAL RESOURCES

Bureau of Land and Water Resources

COUNTY WELL LOCATED MONROE		
WELL NUMBER UNKNOWN	CODED <input checked="" type="checkbox"/>	PERMIT NUMBER
DATE WELL COMPLETED 10-16-86		NAME OF DRILLING FIRM LAYNE-CENTRAL CO.
CLEVELAND, MS		

P.O. Box 10631
Jackson, Mississippi 39209
WATER WELL DRILLERS LOG

NAME & MAILING ADDRESS OF LANDOWNER			
VILLAGE OF GATTMAN			
P.O. BOX 206			
GATTMAN, MS 38844			
WELL LOCATION:	SEC	TOWNSHIP	RANGE
	1	14 S	17 W
DISTANCE	DIRECTION	NEAREST TOWN	
3 Miles	SE	of GATTMAN	
OTHER LANDMARK			
WELL PURPOSE: Home, Irrigation, Municipal, Industrial, Fish Pond, etc.			
MUNICIPAL			

PUMP DATA			
PUMP TYPE (Circle One): Submersible, Turbine , Jet, Flowing Well, Other (Describe)			
POWER TYPE (Circle One): Electric , Tractor, Diesel, Gasoline, Butane, Other (Describe) H/P 7.5			
Pump Capacity (GPM)	No. of Stages	Setting Depth	
150	4	144 FT.	
PUMP TEST			
Well yielded 151 GPM with a drawdown of 7' 10" ft. after 3 hours of pumping			

WELL DATA		
Well Depth 158'	Casing Diameter (In.) 12"	Casing Length (Ft.) 123'
Type of Casing ST. ST.	Hole Depth 158'	Depth to Static Water Level 58'
TYPE OF COMPLETION: (Circle One or More): Gravel Packed , Underreamed , Telescoped, Natural Development, Open Hole, Other		
Top of Lap Pipe or Reduction in Casing 94 FEET IF TELESCOPED OR MORE THAN ONE SCREEN: USE BACK PAGE		

LOG DATA	
TYPE OF LOG RUN (Circle One): Electric , No Log Run, Gamma Ray, Density, Sonic, Neutron, Other (Describe)	
Name of Organization Running Log MS BUREAU OF GEOLOGY	

SCREEN DATA		
Diameter - Inches 6"	Length - Feet 30'	Slot Size - Inches .020
Screen Type WIRE-WRAPPED S.S.	Depth to Bottom - Feet 5'	

GEOLOGIC DATA (Office Use Only)			
Surface Elev.	Geologic Unit	Unit Thickness	Depth to Top
Subs. SWL	Date	Analysis	Aquifer Test


Driller's Remarks

DESCRIPTION OF FORMATIONS ENCOUNTERED	FROM	TO
SILT	0	8
BLUE CLAY	8	84
SAND GRAVEL	84	158

FORMATIONS (Continued)	FROM	TO
RECEIVED		
JUN 07 1988		
Department of Natural Resources Bureau of Land & Water Resources		
IF MORE SPACE IS NEEDED, USE BACK		

If well telescopes please
sketch and show depths.

GROUND LEVEL

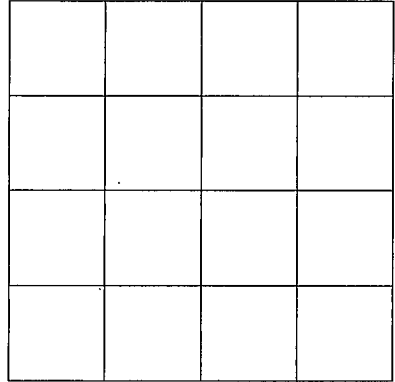

SECTION _____

Please indicate well location X.

ADDITIONAL INFORMATION

If more than one screen,
show location of each on sketch.