

N 201

Monroe
~~6-67~~
6-67

MISSISSIPPI
BOARD OF WATER COMMISSIONERS
416 North State Street
Jackson, Mississippi 39201

WATER WELL DRILLERS LOG

6-2 1968 W. J. REEVES & SON MONROE
date well completed firm name county well located

LANDOWNER: O. D. HUSKY

GREENWOOD SPRINGS

MISS.
(mailing address)

WELL LOCATION:

sec. 18 T 14 S R 19 W
10 miles E of ABERDEEN
(distance) (direction) (nearest town)

WELL PURPOSE: HOME
(home, irrigation, municipal, industrial)

WELL COMPLETION DATA:

- (1) diameter (inches) 4
- (2) total depth (feet) 111
- (3) static water level (feet) 50' below top of ground.
- (4) casing PVC 91' (material) (depth)
4" (size) if telescope see back.
- (5) screen 20' 91' (length) (depth to top)
4" PVC (size) (material)
- (6) pump 3/4 12 (HP) (yield gpm)
ELECT. (type power)
- (7) electric log NO (yes or no)
(organization running log)
- (8) how well bottom plugged SAND

description of formations encountered

from to

RED CLAY	0	22
" SAND	22	78
YELLOW CLAY	78	82
RED SAND	82	109
BLUE CLAY	109	111


JUN 24 1968
MISS. Bd. of WATER COMM.

DRILLERS REMARKS:

9 1/2" DRILL HOLE
GRAVEL PACKED

If well telescopes please sketch and show depths.

GROUND LEVEL

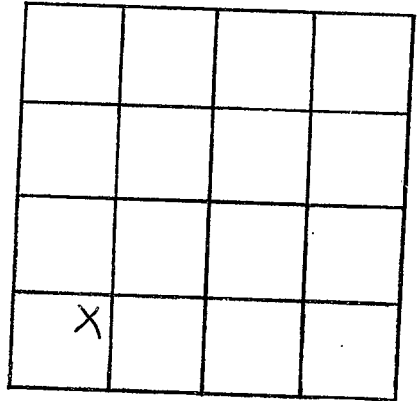

SECTION 18

Please indicate well location X.

ADDITIONAL INFORMATION

If more than one screen,
show locations of each on sketch.