

Monroe  
N 2082  
4-29-75

MISSISSIPPI  
BOARD OF WATER COMMISSIONERS  
416 North State Street  
Jackson, Mississippi 39201

WATER WELL DRILLERS LOG

4-29 1975 W. J. REEVES & SON MONROE  
date well completed firm name county well located


LANDOWNER: MRS. BESSIE JAUDON	description of formations encountered	from	to
GREENWOOD SPRINGS (mailing address)	CLAY	0	30
	BLUE SILT	30	38
	" CLAY	38	115
	" SAND	115	140
WELL LOCATION: sec 72 T 14 N R 17 E 13D S W 8 miles SO of GREENWOOD SPRINGS (distance) (direction) (nearest town)			
WELL PURPOSE: HOME (home, irrigation, municipal, industrial)			
WELL COMPLETION DATA:			
(1) diameter (inches) 4			
(2) total depth (feet) 140			
(3) static water level (feet) 104 below top of ground.			
(4) casing PVC, 120 (material) (depth) 4 If telescope see back. (size)			
(5) screen 20, 120 (length) (depth to top) 4, PVC (size) (material)			
(6) pump 3/4 5 (HP) (yield gpm) ELECT (type power)			
(7) electric log NO (yes or no)			
(organization running log)			
(8) how well bottom plugged SAND			
DRILLERS REMARKS:			

RECEIVED  
NOV 24 1975

RD. OF WATER COMMISSIONERS

If well telescopes please  
sketch and show depths.

GROUND LEVEL

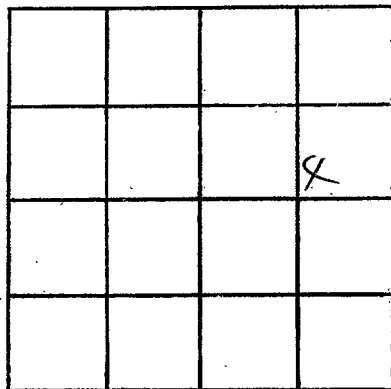

SECTION 32

Please indicate well location X.

ADDITIONAL INFORMATION

If more than one screen,  
show locations of each on sketch.