

Monroe  
N 2003  
5-6-75

MISSISSIPPI  
 BOARD OF WATER COMMISSIONERS  
 416 North State Street  
 Jackson, Mississippi 39201

WATER WELL DRILLERS LOG

5-0 1975 W. J. REEVES, SON MONROE  
 date well completed firm name county well located


LANDOWNER: <u>W. R. ISBELL</u>	description of formations encountered	from	to
<u>GREENWOOD SPRINGS</u> (mailing address)	<u>RED CLAY</u>	<u>0</u>	<u>22</u>
WELL LOCATION: sec <u>29</u> T <u>14</u> S R <u>17</u> E W	<u>RED SAND</u>	<u>22</u>	<u>96</u>
<u>12</u> miles <u>E</u> of <u>ABERDEEN</u> (distance) (direction) (nearest town)	<u>BLUE CLAY</u>	<u>96</u>	<u>98</u>
WELL PURPOSE: <u>HOME</u> (home, irrigation, municipal, industrial)			
WELL COMPLETION DATA:			
(1) diameter (inches) <u>4</u>			
(2) total depth (feet) <u>98</u>			
(3) static water level (feet) <u>60</u> below above top of ground.			
(4) casing <u>PVC</u> , <u>78</u> , (material) (depth) <u>4</u> if telescope see back. (size)			
(5) screen <u>20</u> , <u>78</u> (length) (depth to top)			
(6) pump <u>4</u> , <u>PVC</u> (size) (material) <u>1/2</u> , <u>10</u> (HP) (yield gpm)			
<u>ELECT</u> (type power)			
(7) electric log <u>NO</u> (yes or no)			
(organization running log)			
(8) how well bottom plugged <u>SAND</u>			
DRILLERS REMARKS:	NOV 28 1975		

RECORDED  
 NOV 28 1975

MISS. Bd. of WATER COMM

If well telescopes please sketch and show depths.

GROUND LEVEL

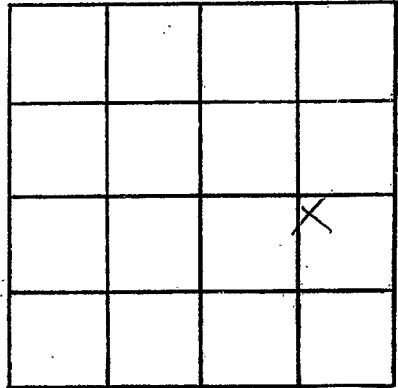

SECTION 29

Please indicate well location X.

ADDITIONAL INFORMATION

If more than one screen,  
show locations of each on sketch.