

MONROE  
 N 2054  
 2-11-76

MISSISSIPPI  
 BOARD OF WATER COMMISSIONERS  
 416 North State Street  
 Jackson, Mississippi 39201

WATER WELL DRILLERS LOG

2-11-1976 date well completed  
 WJ REEVES SON firm name  
 MONROE county well located

LANDOWNER: THOMAS RENNRO  
 RT. 2  
 ABERDEEN  
 (mailing address)

description of formations encountered	from	to
	RED CLAY + SAND	0
BLUE CLAY	80	96
BLUE SAND + CLAY	96	120

WELL LOCATION:  
 sec. 6 T 14 N R 17 E  
 S W  
 10 miles SE of AMARY  
 (distance) (direction) (nearest town)


WELL PURPOSE: HOME  
 (home, irrigation, municipal, industrial)

- WELL COMPLETION DATA:
- (1) diameter (inches) 4
  - (2) total depth (feet) 120
  - (3) static water level (feet) 80 below top of ground.
  - (4) casing PVC, 100 (material) (depth)  
 4 (size) if telescope see back.
  - (5) screen 20, 100 (length) (depth to top)  
 4, PVC (size) (material)
  - (6) pump NONE (HP) (yield gpm)  
 (type power)
  - (7) electric log No (yes or no)  
 (organization running log)
  - (8) how well bottom plugged SAND

DRILLERS REMARKS:

If well telescopes please sketch and show depths.

GROUND LEVEL

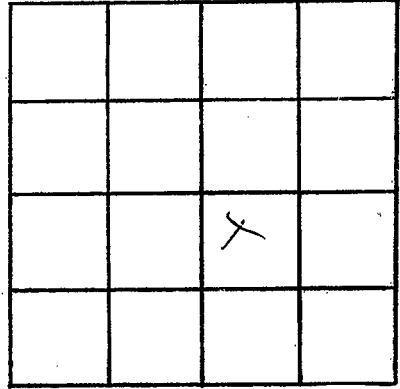

SECTION 6

Please indicate well location X.

ADDITIONAL INFORMATION

If more than one screen, show locations of each on sketch.