

Monroe  
N 2005  
5-25-76

MISSISSIPPI  
 BOARD OF WATER COMMISSIONERS  
 416 North State Street  
 Jackson, Mississippi 39201

WATER WELL DRILLERS LOG

5-28 1976 W.J. REEVES & SON MONROE  
 date well completed firm name county well located

LANDOWNER: MICHAEL WHITAKER  
 GREENWOOD SPRINGS  
 (mailing address)

description of formations encountered	from	to
	RED CLAY	0
" SAND	24	138

WELL LOCATION:  
 sec. 17 T 14 N R 12 E  
                   S                  W  
11 miles E of ABERDEEN  
 (distance) (direction) (nearest town)

WELL PURPOSE: HOME  
 (home, irrigation, municipal, industrial)

- WELL COMPLETION DATA:
- (1) diameter (inches) 4
  - (2) total depth (feet) 138
  - (3) static water level (feet) 70 below above top of ground.
  - (4) casing PVC 118  
           (material) (depth)  
4 if telescope see back.  
           (size)
  - (5) screen 20 118  
           (length) (depth to top)  
4 PVC  
           (size) (material)
  - (6) pump 1/2 7  
           (HP) (yield gpm)  
ELECT  
           (type power)
  - (7) electric log NO  
                   (yes or no)

(organization running log)  
 (8) how well bottom plugged SAND


DRILLERS REMARKS:

MISSISSIPPI STATE UNIVERSITY  
 MISSISSIPPI STATE UNIVERSITY

JUL - 6 1976

If well telescopes please sketch and show depths.

GROUND LEVEL

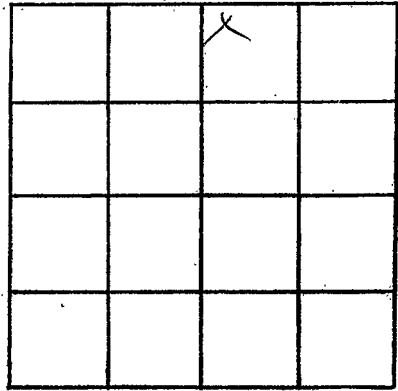

SECTION 17

Please indicate well location X.

ADDITIONAL INFORMATION

If more than one screen,  
show locations of each on sketch.