

Monroe
N 2006
2-13-76

MISSISSIPPI
 BOARD OF WATER COMMISSIONERS
 416 North State Street
 130 Jackson, Mississippi 39201

WATER WELL DRILLERS LOG

2-13 1976 W. J. REEVES & SON MONROE
 date well completed firm name county well located

LANDOWNER: R. W. WARREN
GREENWOOD SPRINGS
 (mailing address)

description of formations encountered	from	to
<u>CLAY</u>	<u>0</u>	<u>30</u>
<u>BLUE SILT</u>	<u>30</u>	<u>39</u>
<u>" CLAY</u>	<u>39</u>	<u>130</u>
<u>WHITE SAND</u>	<u>130</u>	<u>154</u>
<u>BLUE CLAY</u>	<u>154</u>	<u>156</u>

WELL LOCATION:
 sec 28 T 14 R 17
 S W
10 miles E of ABERDEEN
 (distance) (direction) (nearest town)

WELL PURPOSE: HOME
 (home, irrigation, municipal, industrial)

WELL COMPLETION DATA:

(1) diameter (inches) 4

(2) total depth (feet) 156

(3) static water level (feet) 97 below above top of ground.

(4) casing PVC, 136
 (material) (depth)
4 if telescope see back.
 (size)

(5) screen 20 136
 (length) (depth to top)
4 PVC
 (size) (material)

(6) pump NONE
 (HP) (yield gpm)
 (type power)


(7) electric log NO
 (yes or no)
 (organization running log)

(8) how well bottom plugged SAND

DRILLERS REMARKS:

If well telescopes please sketch and show depths.

GROUND LEVEL

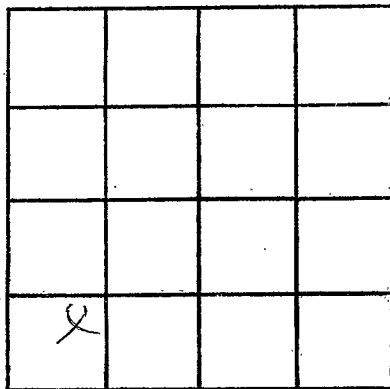

SECTION 28

Please indicate well location X.

ADDITIONAL INFORMATION

If more than one screen,
show locations of each on sketch.