

MONROE
N 2008
11-19-76

MISSISSIPPI
 BOARD OF WATER COMMISSIONERS
 416 North State Street
 Jackson, Mississippi 39201

WATER WELL DRILLERS LOG

11-19-1976
 date well completed

13L

J. REEVES SON
 firm name

MONROE
 county well located

LANDOWNER: JIMMY BREWER

description of formations encountered

from

to

GREENWOOD SPRINGS

RED CLAY	0	25
RED SAND + CLAY	25	110
BLUE CLAY	110	112

(mailing address)

WELL LOCATION:

sec. 5 T. 14 N. R. 17 E.
 10 miles SE of AMORY
 (distance) (direction) (nearest town)

WELL PURPOSE: HOME
 (home, irrigation, municipal, industrial)

WELL COMPLETION DATA:

- (1) diameter (inches) 4
- (2) total depth (feet) 112
- (3) static water level (feet) 77 below top of ground.
- (4) casing PVC, 92 (material) (depth)
 4 (size) if telescope see back.
- (5) screen 20 (length) 92 (depth to top)
 4 (size) PVC (material)
- (6) pump (HP) (yield gpm)
 (type power)
- (7) electric log NO (yes or no)

(organization running log)

(8) how well bottom plugged SAND

DRILLERS REMARKS:


RECEIVED

APR 12 1977

MISS. BD. OF WATER COMMISSIONERS

If well telescopes please sketch and show depths.

GROUND LEVEL

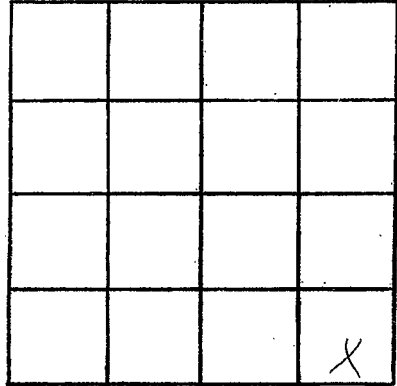

SECTION 5

Please indicate well location X.

ADDITIONAL INFORMATION

Lined area for additional information.

If more than one screen, show locations of each on sketch.