

Monroe
 N 2010
 7-25-81

MISSISSIPPI
 BOARD OF WATER COMMISSIONERS
 416 North State Street
 Jackson, Mississippi 39201
 WATER WELL DRILLERS LOG

7-25 1981 Monroe's Ridgeway Monroe
 date well completed firm name county well located

LANDOWNER: Raymond Lee Ridgeway description of formations encountered from to
R. 2 Box 361
Hamilton ms.
 (mailing address) clay 0 37
sand & clay
gravel 37 119

WELL LOCATION:
 sec. 25 T. 14 N. R. 19 E. S. 1
7 miles NE of Harrison
 (distance) (direction) (nearest town)

WELL PURPOSE: home
 (home, irrigation, municipal, industrial)

WELL COMPLETION DATA:

- (1) diameter (inches) 4"
- (2) total depth (feet) 119'
- (3) static water level (feet) 76 below above top of ground.
- (4) casing PVC, 109'
 (material) (depth)
 (size) if telescope see back.
- (5) screen 10', 109
 (length) (depth to top)
4", PVC
 (size) (material)
- (6) pump 1/2, 10
 (HP) (yield gpm)
Σ
 (type power)
- (7) electric log _____
 (yes or no)


 (organization running log)
- (8) how well bottom plugged _____

DRILLERS REMARKS:

DEPT. OF NATURAL RESOURCES
 BUREAU OF LAND & WATER RESOURCES

AUG 25 1981

RECEIVED

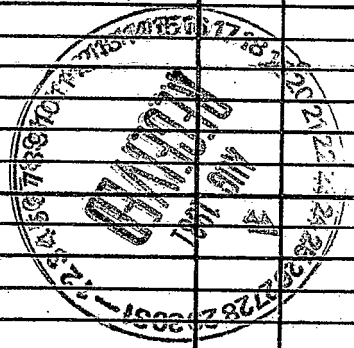

If well telescopes please sketch and show depths.

GROUND LEVEL

SECTION _____

Please indicate well location X.

ADDITIONAL INFORMATION

If more than one screen, show locations of each on sketch.