

Increase
N
2011

MISSISSIPPI
 BOARD OF WATER COMMISSIONERS
 416 North State Street
 Jackson, Mississippi 39201


WATER WELL DRILLERS LOG

October 18, 1982 Mid South Drilling Company Monroe
 date well completed firm name county well located

LANDOWNER: Ralph Dill & Son Building Rt. 1 Smithville, MS 38870 (mailing address)	Location of formations encountered	from	to
	clay	0	15
	sand	15	120
WELL LOCATION:			
sec. 25 T. 14 N. R. 19 E. S. 3			
4 miles east of Westville (distance) (direction) (nearest town)			
WELL PURPOSE: home (home, irrigation, municipal, industrial)			
WELL COMPLETION DATA:			
(1) diameter (inches) 4			
(2) total depth (feet) 120			
(3) static water level (feet) 60 below top of ground. 380 ft			
(4) casing PVC, 110 (material) (depth) 4 (size) If telescope see back.			
(5) screen 10' (length), 110' (depth to top) 4" (size), .032 PVC (material)			
(6) pump 1/2 (HP), 5 (yield gpm) electric (type power)			
(7) electric log no (yes or no) none (organization running log)			
(8) how well bottom plugged screen			
DRILLERS REMARKS:			

If well telescopes please sketch and show depths.

GROUND LEVEL

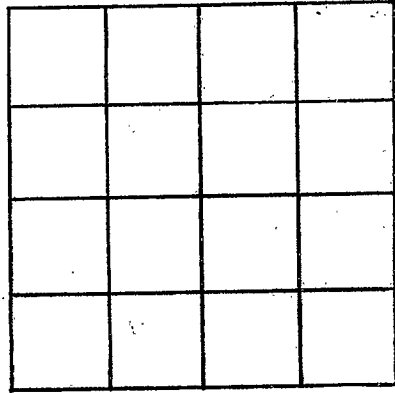

SECTION _____

Please indicate well location X.

ADDITIONAL INFORMATION

If more than one screen, show locations of each on sketch.