

Monroe
 021
 3-31-69

MISSISSIPPI
 BOARD OF WATER COMMISSIONERS
 416 North State Street
 Jackson, Mississippi 39201

WATER WELL DRILLERS LOG

Herndon-Homan Well & Supply, Inc.

3-31 1969
 date well completed

P. O. Box 42

DELANNOY, MISSISSIPPI 38868 county well located

Monroe

LANDOWNER: contractor
L.C. Cook
At: Phisic, Miss
 (mailing address)

description of formations encountered

from to

Surface clay 0-26
Blue clay 26-280
Sand 280-400
Rock 400

WELL LOCATION:

sec. 5 T. 16 N. R. 6 E.
 S W
2 miles SW of Mulden
 (distance) (direction) (nearest town)

WELL PURPOSE:

(home, irrigation, municipal, industrial)
Home

WELL COMPLETION DATA:

- (1) diameter (inches) 5
- (2) total depth (feet) 400
- (3) static water level (feet) 85 above top of ground.
- (4) casing Steel, 30'
 (material) (depth)
5 if telescope see back.
 (size)
- (5) screen RD,
 (length) (depth to top)
 (size) (material)
- (6) pump 1/2 5
 (HP) (yield gpm)
electric
 (type power)
- (7) electric log No
 (yes or no)

(organization running log)

(8) how well bottom plugged open

MAY 26 1969


MISC. DD. OF
 WATER COMM.

DRILLERS REMARKS:

Contractor Job

If well telescopes please sketch and show depths.

GROUND LEVEL

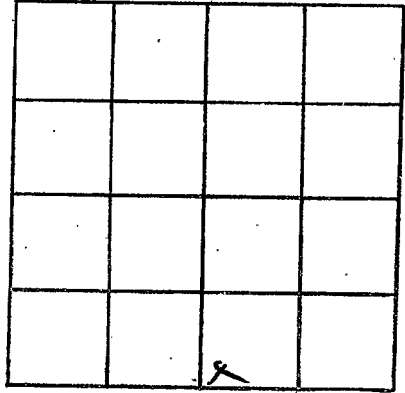

SECTION 5

Please indicate well location X.

ADDITIONAL INFORMATION

A series of horizontal lines for writing additional information, starting below the 'ADDITIONAL INFORMATION' header and extending to the bottom of the page.

If more than one screen, show locations of each on sketch.