

Monroe
 023
 5-13-69

MISSISSIPPI
 BOARD OF WATER COMMISSIONERS
 416 North State Street
 Jackson, Mississippi 39201

WATER WELL DRILLERS LOG

Merndon-Homan Well & Supply, Inc.
 P. O. Box 42

5-13 1969
 date well completed

SEANVILLE, MISSISSIPPI 38665
 county well located


LANDOWNER:
 Henry Cunningham
 Prairie, Miss.
 (mailing address)

description of formations encountered	from	to
Sandy mud & clay	0-26	
Blue clay	26-280	
Sand	280-400	
Bitum	400	

WELL LOCATION:
 sec. 17 T-15 N R-6 E
 1 1/2 miles SW of Prairie
 (distance) (direction) (nearest town)

WELL PURPOSE: Home
 (home, irrigation, municipal, industrial)

- WELL COMPLETION DATA:
- diameter (inches) 5
 - total depth (feet) 400
 - static water level (feet) _____ below/above top of ground.
 - casing Steel 31'6"
 (material) (depth)
5 If telescope see back.
 (size)
 - screen ND _____
 (length) (depth to top)
 (size) (material)
 - pump ND _____
 (HP) (yield gpm)
 (type power)
 - electric log NO
 (yes or no)
 (organization running log)
 - how well bottom plugged Good

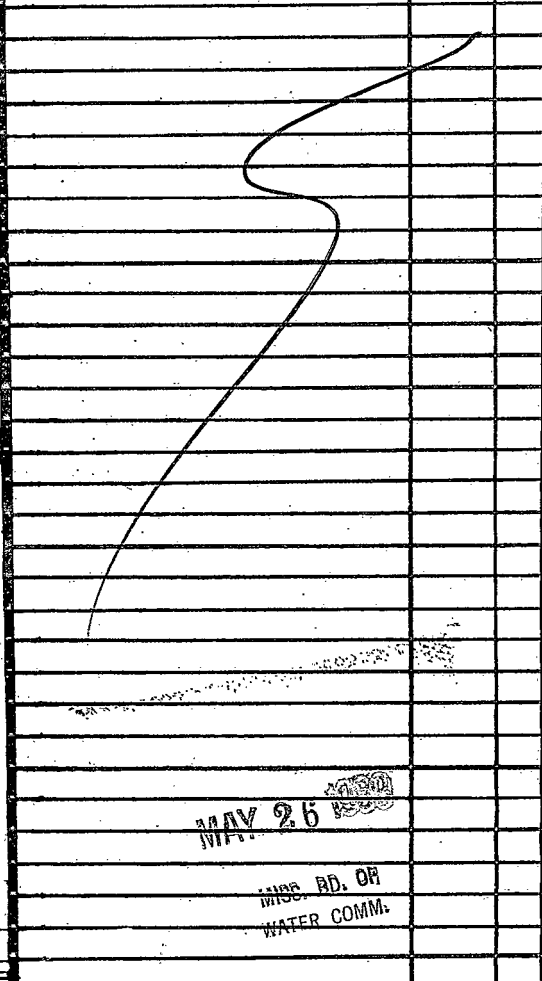


MAY 26 1969
 MISS. RD. OR
 WATER COMM.

DRILLERS REMARKS:

If well telescopes please sketch and show depths.

GROUND LEVEL

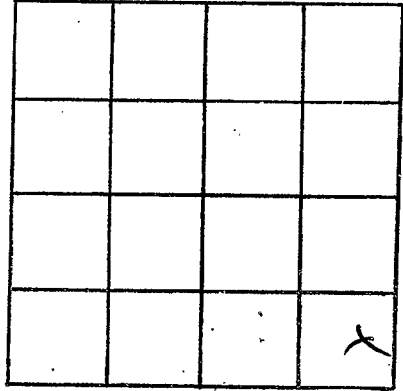

SECTION C7

Please indicate well location X.

ADDITIONAL INFORMATION

A series of horizontal lines for writing additional information, starting below the 'ADDITIONAL INFORMATION' header and extending to the bottom of the page.

If more than one screen, show locations of each on sketch.