

Monroe
024
6-10-69

MISSISSIPPI
 BOARD OF WATER COMMISSIONERS
 416 North State Street
 Jackson, Mississippi 39201

CODED

WATER WELL DRILLERS LOG

Herdon-Homan Well & Supply, Monroe

6-10 19 69
 date well completed

SEANNOON, MISSISSIPPI 38868
 county well located

LANDOWNER:

Joe Alvin Eades
At 1 Prairie Miss
 (mailing address)

description of formations encountered

from to

Surface clay 0 - 25
Other clay 25 - 280
Sand 280 - 400
Bottom 400

WELL LOCATION:

sec. 19 T 15 N R 6 E
 S W
3 miles SW of Prairie
 (distance) (direction) (nearest town)

WELL PURPOSE:

Home
 (home, irrigation, municipal, industrial)

WELL COMPLETION DATA:

- (1) diameter (inches) 5
- (2) total depth (feet) 400
- (3) static water level (feet) 100 below top of ground.
- (4) casing Steel, 35'
 (material) (depth)
5 If telescope see back.
 (size)
- (5) screen AD,
 (length) (depth to top)
 (size) (material)
- (6) pump 1/2 5
 (HP) (yield gpm)
elect
 (type power)
- (7) electric log NO
 (yes or no)

(organization running log)

(8) how well bottom plugged open


DRILLERS REMARKS:

JUL 11 1969

Mississippi
 BOARD OF WATER COMMISSIONERS

If well telescopes please sketch and show depths.

GROUND LEVEL

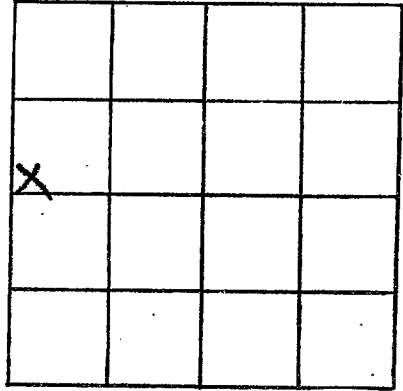

SECTION 17

Please indicate well location X.

ADDITIONAL INFORMATION

If more than one screen,
show locations of each on sketch.