

Monroe
025
6-25-69

MISSISSIPPI
 BOARD OF WATER COMMISSIONERS
 416 North State Street
 Jackson, Mississippi 39201

CODED

WATER WELL DRILLERS LOG
 Herndon-Homan Well & Supply, Inc.
 P. O. Box 42
~~SLANON, MISSISSIPPI 39066~~

6-25-69
 date well completed

Monroe
 county well located

LANDOWNER: L.C. Cook

description of formations encountered

from

(Contractor)

Aberdeen, Miss.
 (mailing address)

Surface clay
Bottom clay 25-280
Sand 280-400
Bottom 400

WELL LOCATION:

sec. 4 T 16 N R 1 E
2 miles S.W. of Muldon
 (distance) (direction) (nearest town)

WELL PURPOSE: home
 (home, irrigation, municipal, industrial)

WELL COMPLETION DATA:

- (1) diameter (inches) 5"
- (2) total depth (feet) 400
- (3) static water level (feet) 70 below top of ground.
- (4) casing Steel 33'10"
 (material) (depth)
- 5"
 (size) if telescope see back.
- (5) screen no
 (length) (depth to top)
- (size) (material)
- (6) pump 1/3 5
 (HP) (yield gpm)
- Electric
 (type power)
- (7) electric log no
 (yes or no)

(organization running log)

(8) how well bottom plugged open


DRILLERS REMARKS:

JUN 11 1969

MISS. BD. OF
 WATER COMM.

If well telescopes please sketch and show depths.

GROUND LEVEL

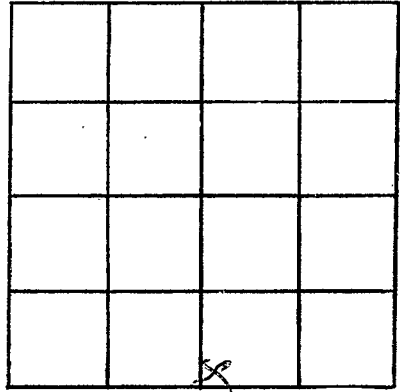

SECTION 9

Please indicate well location X.

ADDITIONAL INFORMATION

If more than one screen, show locations of each on sketch.