

48,3

CODED

MISSISSIPPI  
BOARD OF WATER COMMISSIONERS  
416 North State Street  
Jackson, Mississippi 39201

WATER WELL DRILLERS LOG

Monroe  
26  
8-69

8-12 date well completed 1969 Henderson-Homan Well Supply firm name Monroe county well located

LANDOWNER: Earl Sanders

Route 1  
Hairie, Miss  
(mailing address)

description of formations encountered	from	to
Surface sand & clay	0	18
Blue clay	18	200
Sand	200	400
Bottom	400	

WELL LOCATION:


sec. 5 T 16 N R 6 E  
1 1/2 miles SW of Wadley  
(distance) (direction) (nearest town)

WELL PURPOSE: home  
(home, irrigation, municipal, industrial)

WELL COMPLETION DATA:


- (1) diameter (inches) 5"
- (2) total depth (feet) 400 FT
- (3) static water level (feet) 70 below top of ground.
- (4) casing Steel 21'2" (material) (depth)  
5" (size) if telescope see back.
- (5) screen NO (length) (depth to top)  
(size) (material)
- (6) pump NO (HP) (yield gpm)  
(type power)
- (7) electric log NO (yes or no)  
(organization running log)
- (8) how well bottom plugged open

DRILLERS REMARKS:

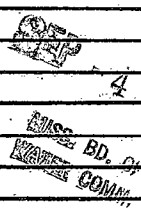

If well telescopes please sketch and show depths.

GROUND LEVEL

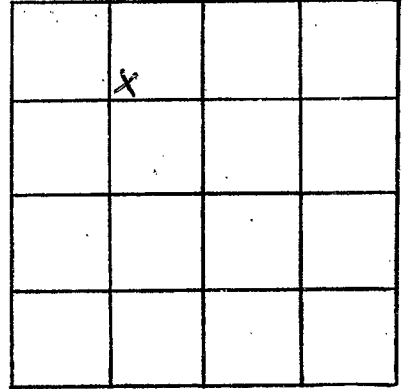

SECTION 5

Please indicate well location X.

ADDITIONAL INFORMATION

If more than one screen,  
show locations of each on sketch.