

MISSISSIPPI  
BOARD OF WATER COMMISSIONERS  
416 North State Street  
Jackson, Mississippi 39201

**CODED**

WATER WELL DRILLERS LOG

Monroe  
D27  
8-28-70

8-28 1970 Herndon-Homan, Inc. Monroe  
date well completed firm name county well located

Contractor  
LANDOWNER: Co-operative Home Builders, Box 510  
Aberdeen, Miss.  
(mailing address)

description of formations encountered	from	to
surface clay	0	18
blue clay	18	200
sand	200	360
B. below	360	

WELL LOCATION:  
sec. 15 T. 15 N. R. 6 E.  
1 miles S of Prairie  
(distance) (direction) (nearest town)

WELL PURPOSE: home  
(home, irrigation, municipal, industrial)

- WELL COMPLETION DATA:
- (1) diameter (inches) 5"
  - (2) total depth (feet) 360'
  - (3) static water level (feet) 158 below top of ground.
  - (4) casing Steel 21' 3" (material) (depth)  
5" (size) if telescope see back.
  - (5) screen no (length) (depth to top)  
(size) (material)
  - (6) pump 1/2 (HP) 5 (yield gpm)  
Electric (type power)
  - (7) electric log no (yes or no)  
(organization running log)
  - (8) how well bottom plugged open

**CODED**


SEP 25 1970

DRILLERS REMARKS:

MISS. BD. OF  
WATER DIVISION

If well telescopes please sketch and show depths.

GROUND LEVEL

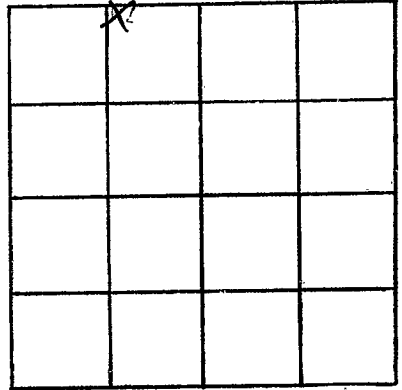

SECTION 15

Please indicate well location X.

ADDITIONAL INFORMATION

If more than one screen,  
show locations of each on sketch.