

Monroe  
 28  
 7-1-70

MISSISSIPPI  
 BOARD OF WATER COMMISSIONERS  
 416 North State Street  
 Jackson, Mississippi 39201

**CODED**

WATER WELL DRILLERS LOG

*Monroe*  
*Clay*

7-1 1970 *Henderson Thomas, Inc* date well completed firm name county well located

LANDOWNER: *Lilly Mae Kelly*  
*Route 3 Box 240*  
*West Point Miss.*  
 (mailing address)

description of formations encountered	from	to
<i>Surface clay</i>	<i>0</i>	<i>13</i>
<i>Blue clay</i>	<i>13</i>	<i>260</i>
<i>Sand</i>	<i>260</i>	<i>400</i>
<i>B&amp;T. on</i>	<i>400</i>	

WELL LOCATION:  
 sec. *5* T. *16N* R. *6E*  
*2 1/2* miles *SW* off *Malden*  
 (distance) (direction) (nearest town)

WELL PURPOSE: *Home*  
 (home, irrigation, municipal, industrial)

- WELL COMPLETION DATA:
- (1) diameter (inches) *5"*
  - (2) total depth (feet) *400'*
  - (3) static water level (feet) *9.5* below/above top of ground.
  - (4) casing *Steel* *30'*  
 (material) (depth)  
*5"* if telescope see back.  
 (size)
  - (5) screen *20*  
 (length) (depth to top)  
 (size) (material)
  - (6) pump *1/2* *5*  
 (HP) (yield gpm)  
*Electric*  
 (type power)
  - (7) electric log *no*  
 (yes or no)  
 (organization running log)
  - (8) how well bottom plugged *open*

**CODED**


JUL 20 1970

DRILLERS REMARKS:

MISS. Bd. of  
 WATER COMMISSIONERS

If well telescopes please sketch and show depths.

GROUND LEVEL

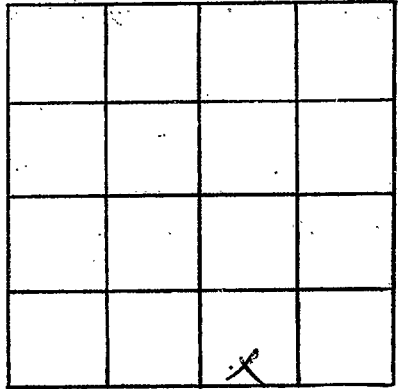

SECTION 5

Please indicate well location X.

ADDITIONAL INFORMATION

If more than one screen, show locations of each on sketch.